

Butler


Form 51-5M-5-34-Peace

Map No. Kansas Sec. 27 Twp. 28 R. 4E

Well No. 8 Martin's Farm

Flint Hill Company

NORTH

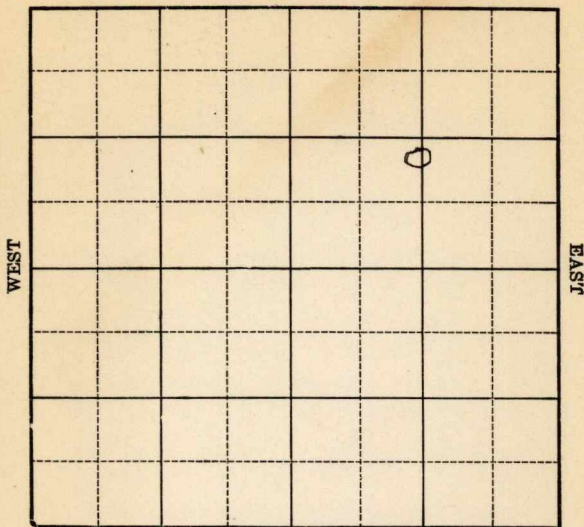

SOUTH

Location

Drilling Remarks

Rig Up

Drilling Remarks

RECORD

Cased _____ in. _____ ft.

Sand _____

Gas _____

Oil _____

Total Depth _____

PRODUCTION

1st 24 hrs. Nat. _____

1st 24 hrs. after shot _____

Gas _____ cu. ft.

Dry Hole _____

Abandoned _____

Butler

Map No. **KANSAS** Sec. 27 Twp. 28 R. 4E

Well No. 8 Martens Farm


Flint Hills Company

_____ Ft. from N. Line

1070 Ft. from S. Line

1320 Ft. from E. Line

_____ Ft. from W. Line

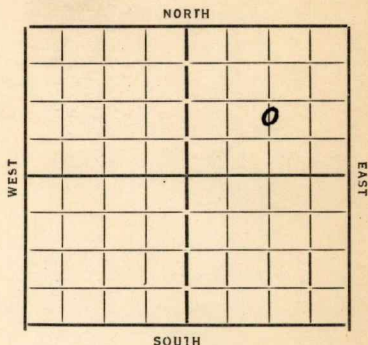

Date
1934

REPORT

10/24 Read line 1435
A. Gas 1458
B. line 1496 TD 1499
40 gts 300,000 Gas.

FIRST REPORTS



COMPLETED

KANSAS

Map No. 11 Sec. 27 Twp. 28 R. 4E

Well No. 8-Martins

Plint Hills

Company

FIRST REPORT

Contractor

+

COMPLETED

SECTION PLAT

_____ Ft. from N. Line

1070 Ft. from S. Line

1320 Ft. from E. Line

_____ Ft. from W. Line

Location _____

Rig up _____

Drilling and Remarks:

Read line 1435

A. gas 1458

B. Line 1496

TD 1499

40 gts

300,000 gas

RECORD

Cased _____ in., _____ ft.

Sand _____

Gas _____

Oil _____

Total Depth _____

PRODUCTION

1st 24 hrs. Nat. _____

1st 24 hrs. after shot _____

Gas _____ Cu. Ft.

Dry Hole _____

Abandoned _____

Date

10-24-34

19

ORVAL MANNSCHRECK

Scout