


Section 13 Township 30 Range 5E

Well No. #2 Couch #A

Company Ryan Consolidated

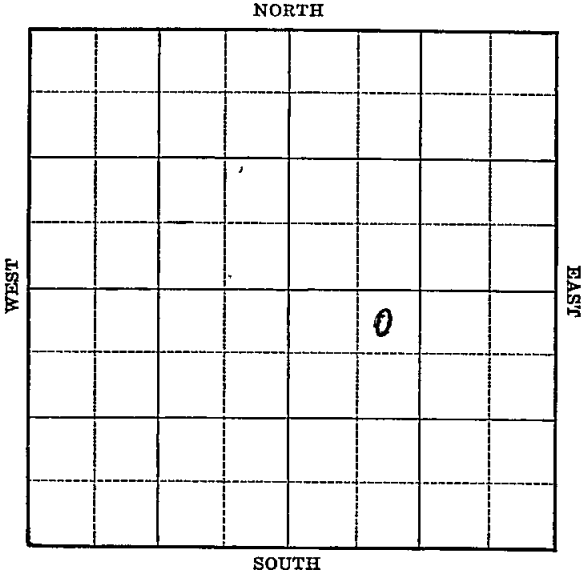

Sec. 13 Twp. 30 R. 5-E

Well No. #2 Couch "A" _____ Farm _____

Ryan Consolidated Company

(Misc)


330 Ft. from N. Line

Ft. from S. Line

Ft. from E. Line

990 Ft. from W. Line

Elev. 1321

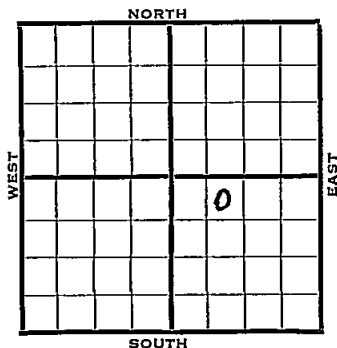

1940	REPORT
7/17	13" - 93'
	Drlg. 430'
7/25	K.C. 2690' Drlg. 2740'
8/2	7" - 2755' Drlg. 2821' S.O.
8/8	T.D. 2821' H.F.O. Shot 200 qts.
	Flow 30 bbls. per hr. 2 hours.
8/14	" " " " "
8/22	" " " " "
8/29	" " " " "
9/5	" " " " "
9/12	" " " " "
9/19	" " " " "
9/26	" " " " "
10/2	" " " " "
10/9	Bart. 2784'
	7" - 2755'
	T.D. 2821'
	Shot 200 qts.
	Depthograph potential 536 bbls.
	COMPLETED

Cowley

KANSAS

Map No. 11 Sec. 13 Twp. 30 R. 5EWell No. 2 Couch "A"Ryan Consolidated Company

Contractor

FIRST REPORT

SECTION PLAT

		o	

NE NW SE
330 Ft. from N. Line Ft. from S. Line Ft. from E. Line990 Ft. from W. Line

Miscellaneous

Location Rig up

Drilling and Remarks:

13" - 93Drilg. 430 :

RECORD

Cased in., ft.Sand Gas Oil Total Depth

PRODUCTION

1st 24 hrs. Nat. 1st 24 hrs. after shot Gas Cu. Ft.Dry Hole Abandoned

Date

JUL 17 194019S. J. LEWIS

Scout

Map No. 11 Sec. 13 Twp. 30 R. 5EWell No. 2 Couch "A"Ryan Consolidated Company

Contractor

COMPLETED

NE NW SE

330 Ft. from N. Line Ft. from S. Line Ft. from E. Line990 Ft. from W. Line**SECTION PLAT**

		o	

MISCELLANEOUSLocation Rig up

Drilling and Remarks:

*Bar 2784**7" @ 2755-**2009 to.**Depth 28586***RECORD**Cased in., ft.Sand Gas Oil Total Depth 2821**PRODUCTION**1st 24 hrs. Nat. 1st 24 hrs. after shot Gas Cu. Ft.Dry Hole Abandoned

Date

OCT 9 1940 19S. J. LEWISScout