


Section 20 Township 15 Range 17W

Well No. #1 Stecklein

Company Jones, Shelborne & Farmer

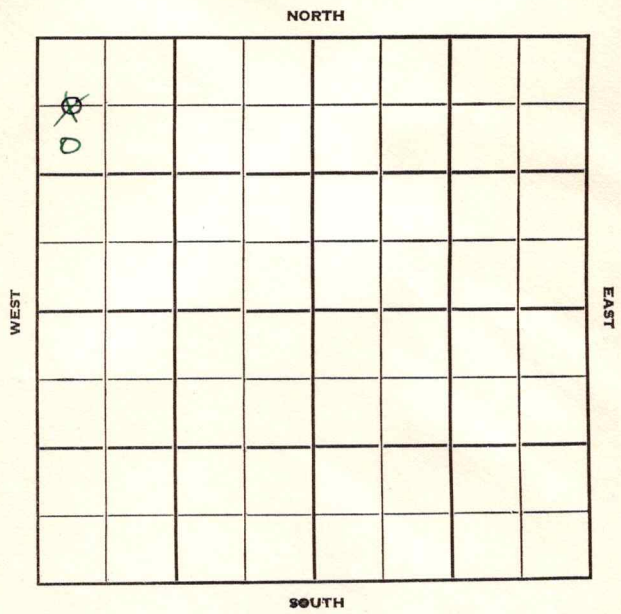

Ellis

KANSAS

Sec. 20 Twp. 15 R. 17W

Well No. #1 Stecklein Farm

Jones, Shelborne & Farmer Company

Contractor

990
660

Wheatland Pool

Ft. from N. Line


Ft. from S. Line

Ft. from E. Line

330

Ft. from W. Line

SW NW NW
6 W L NW NW

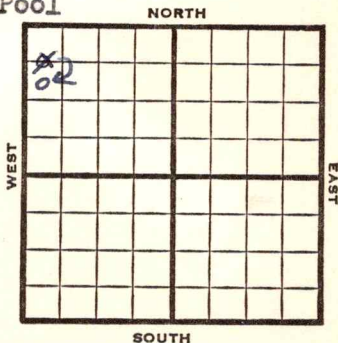

1951

Elev. 1991' REPORT

12/5

Spud 12-3-51
Drlg. 404'

1952

2/6

TD 3616 5" @ 3410 POP
P. 70 BOPD

2/13

No report

2/20

"

3/5

"

12/3

Spud 12-3-51

Oil Well TD 3616

8" @ 880 Heeb. 3239 Tor. 3260

KC 3290

DST 3306-29 opn 10 min. Rec. 205'


hq & gcm Cong. 3541

Arb. 3606 5" @ 3410

27/3307-16 12/3326-30 1000 A

S/6 boph 10 hr. Comp. 10 bopd 10% wtr

COMPLETED

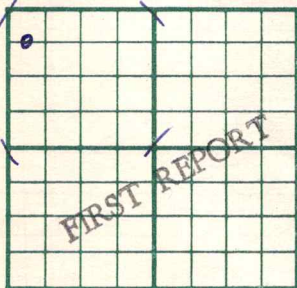County **Ellis** State **Kansas**Sec. **20** (Blk.) **15** (Sur.) **17W** Map No.Operator **Jones, Shelborne & Farmer**Well No. **1** Farm **Stecklein**Elev. Location **C W L NW NW****660** Ft. From **N** Line **NW****330** Ft. From **W** Line **Quarter**1st. Report **DEC 5 1951**

Completion

Remarks

Spudding Date **12-3-51**Drlg. Data **Wheatland Pool****drlg. 404**

J. E. TYRA

Kansas

Map No. _____ Sec. 20 Twp. 15 R. 17WWell No. 1 SteckleinJones-Shelborne & Farmer Company

CORRECTION

Contractor

SW NW NW

SECTION PLAT

0			

990 Ft. from N. Line

_____ Ft. from S. Line

_____ Ft. from E. Line

330 Ft. from W. LineEllis County

Location _____

Rig up _____

Drilling and Remarks:

Reported

C W L NW NW

RECORD

Cased _____ in., _____ ft.

Sand _____

Gas _____

Oil _____

Total Depth _____

PRODUCTION

1st 24 hrs. Nat. _____

1st 24 hrs. after shot _____

Gas _____ Cu. Ft.

Dry Hole _____

Abandoned _____

Date

DEC 1 2 1951

19

J. E. TYRA

Scout

County Ellis State
 Sec. 20 (Blk.
Twp.) 15 (Sur.
Rge.) 17W Map No.

Operator Jones, Shelborne & Farmer

Well No. 1 Farm Stecklein

Elev. 1991 Location SW NW NW

0

COMPLETE

990 Ft. From N Line NW

330 Ft. From W Line Quarter

1st. Report

Completion MAR 1 2 1952

Remarks Wheatland Pool

Sauvage & Dunn - Contr.

Spudding Date 12-3-51

Drlg. Data Oil well TD 3616

8" @ 880 Heeb. 3239 Tor. 3260

KC 3290 DST 3306-29 open 10 min.

Rec. 205' ho & gcm Cong. 3541

Arb. 3606 5" @ 3410 27/ 3307-16

12/ 3326-30 1000 A S/ 6 boph 10 hr.

Comp. 10 bopd. 10% water

