


Map No. _____ Sec 28 Twp 28 R 4Well No. 1- Blood Farm _____Big Jury Oil Company _____

NORTH

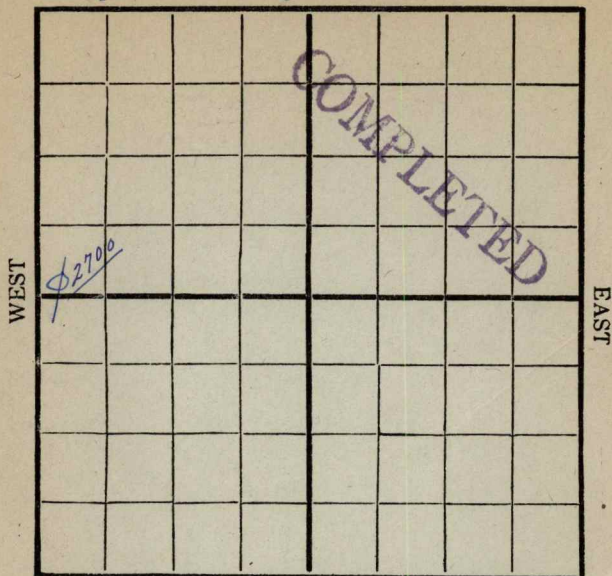

SOUTH

Location _____

Rig Up 10/23/16

Drilling Remarks:

Drilling Remarks:

930 = 11/9
1200 = 11/14
1990 = 11/27
2280 = 12/4
2502' = 12/11
2620' = 12/18

RECORD

PRODUCTION

Cased _____ in _____ Ft.

1st 24 hrs. Nat _____

Sand _____

1st 24 hrs. after shot _____

Gas _____

Gas _____ Cu. Ft.


Oil _____

Dry Hole _____

Total Depth _____

Abandoned _____

Map No. _____ Sec. 28 Twp. 28 R. 4
 Well No. 1 Blind Farm _____
Big Jerry Oil Company _____
 NORTH

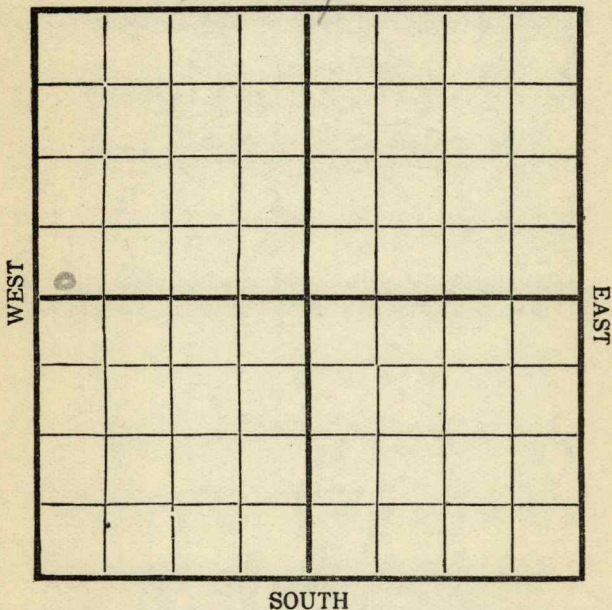

Location _____
 Rig Up ✓
 Drilling and remarks _____

RECORD

Cased _____ in. _____ Ft.
 Sand _____
 Gas _____
 Oil _____
 Total Depth _____

PRODUCTION

1st 24 hrs. Nat. _____
 First 24 h. s. after shot _____
 Gas _____ Cu. Ft.
 Dry Hole _____
 Abandoned _____

Date

10/23, 1916 Scout


Map No. _____ Sec. 28 Twp. 28 R. 4

Well No. 1300 Farm _____

Big Jerry Company _____

NORTH

WEST

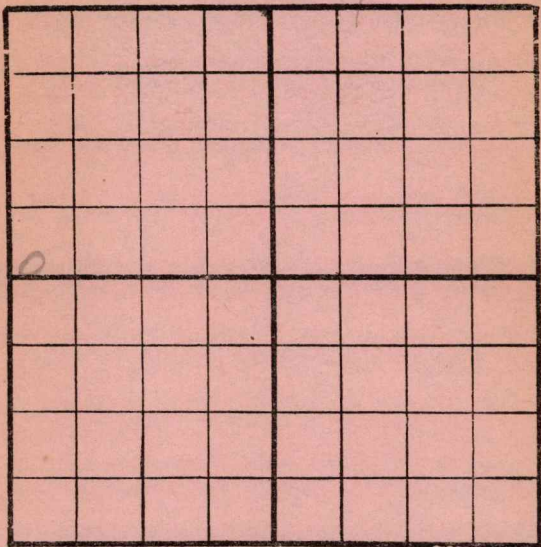

EAST

SOUTH

Location _____

Rig up _____

Drilling and remarks _____

RECORD

Cased _____ in. _____ Ft.

Sand _____

Gas _____

Oil _____

Total Depth _____

PRODUCTION

1st. 24 hrs. Nat. _____

1st 24 hrs. after shot _____

Gas _____ Cu. Ft.

Dry Hole _____

Abandoned _____


Date

10/30, 1916 _____ Scout

Map No. _____ Sec. 28 Twp. 28 R. 4
 Well No. 130 Farm _____
Big Jerry Company _____

NORTH

WEST

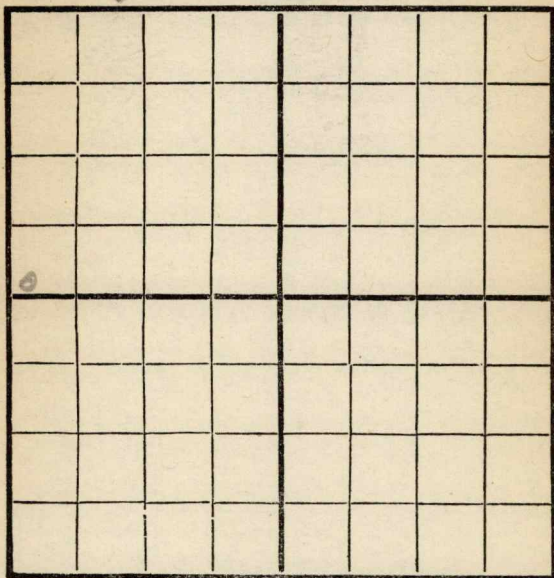

EAST

SOUTH

Location _____

Rig Up _____

Drilling and remarks

230

RECORD

Cased _____ in. _____ Ft.

Sand _____

Gas _____

Oil _____

Total Depth _____

PRODUCTION

1st 24 hrs. Nat. _____

First 24 hrs. after shot _____

Gas _____ Cu. Ft.

Dry Hole _____

Abandoned _____


Date

11/9, 191 6 Scout

Map No. _____ Sec. 28 Twp. 38 R. 4
 Well No. 13 Farm _____
Big Jerry Company _____

NORTH

WEST

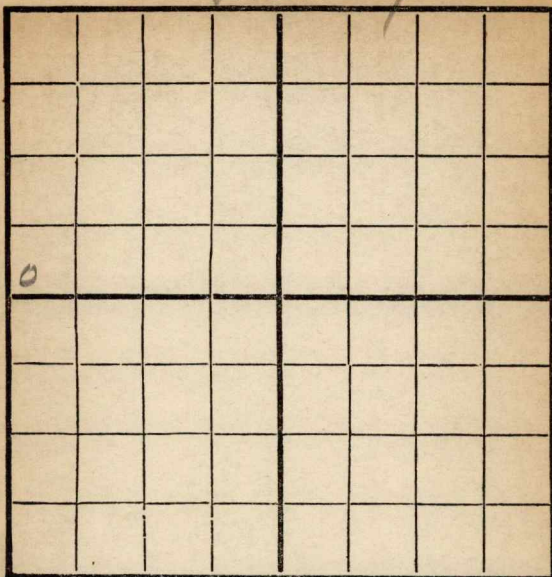

EAST

SOUTH

Location _____
 Rig Up _____
 Drilling and remarks _____

1200

RECORD

Cased _____ in. _____ Ft.
 Sand _____
 Gas _____
 Oil _____
 Total Depth _____

PRODUCTION

1st 24 hrs. Nat. _____
 First 24 hrs. after shot _____
 Gas _____ Cu. Ft.
 Dry Hole _____
 Abandoned _____

Date

11/14, 1916 Candy Scout

1002 K 11
 Map No. _____ Sec. 28 Twp. 24 R. 4
 Well No. 18002
 Dry Ferry Oil Co. Company
 _____ Contractor

NORTH



SOUTH

Location _____

Rig up _____

Drilling and Remarks:

RECORD

Cased _____ in., _____ ft.

Sand _____

Gas _____

Oil _____

Total Depth _____

PRODUCTION

1st 24 hrs. Nat. _____

1st 24 hrs. after shot _____

Gas _____ Cu. Ft.

Dry Hole _____

Abandoned _____

Date

11/20 1916 Cardiff Scout

Map No. _____ Sec. 28 Twp. 28 R. 4Well No. 1300 Farm _____Company Big Jerry Oil

NORTH

WEST

EAST

SOUTH

Location _____

Rig Up _____

Drilling and remarks

1980

RECORD

Cased _____ in. _____ Ft.

Sand _____

Gas _____

Oil _____

Total Depth _____

PRODUCTION

1st 24 hrs. Nat. _____

1st 24 hrs. after shot _____

Gas _____ Cu. Ft.


Dry Hole _____

Abandoned _____

Date

11/27, 1916 Candy Scout

Map No. _____ Sec. 28 Twp. 28 R. 4
 Well No. 1 Blood Farm _____
Big Jerry Company _____
 NORTH

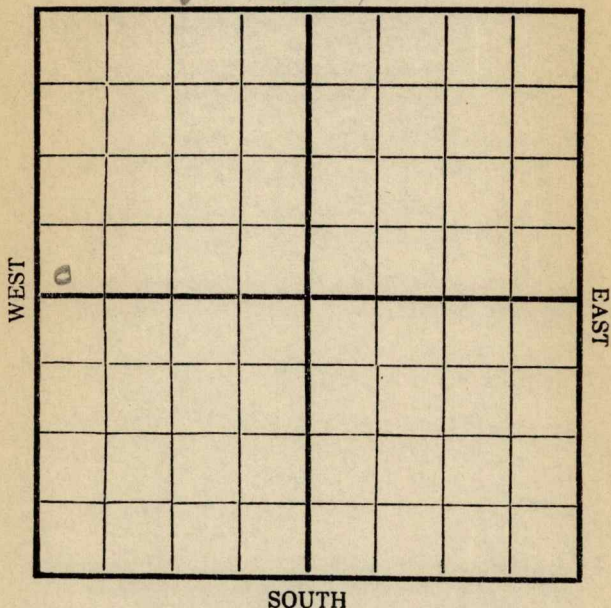

Location _____
 Rig Up _____
 Drilling and remarks

2280'

RECORD

Cased _____ in. _____ Ft.
 Sand _____
 Gas _____
 Oil _____
 Total Depth _____


PRODUCTION

1st 24 hrs. Nat. _____
 1st 24 hrs. after shot _____
 Gas _____ Cu. Ft.
 Dry Hole _____
 Abandoned _____

Date

10/4, 1916, Conroy Scout

Map No. _____ Sec. 28 Twp. 28 R. 4
 Well No. 1 Blood Farm _____
Big Jerry Oil Company _____

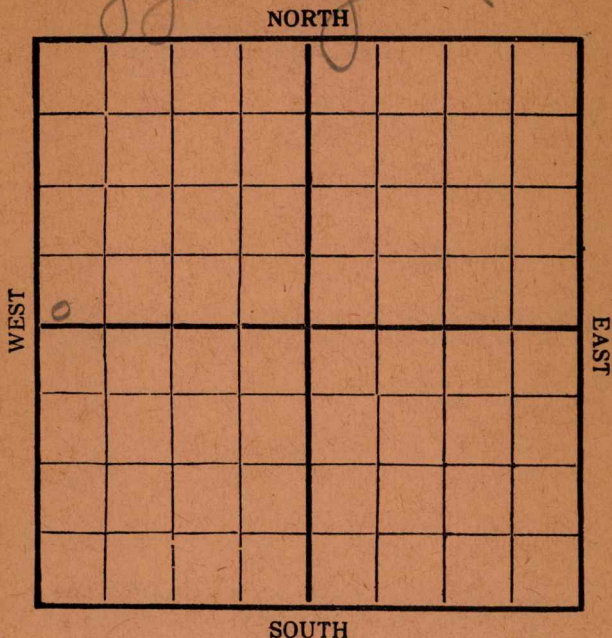

Location _____
 Rig Up _____
 Drilling and remarks _____

2502'
Coring

RECORD

Cased _____ in. _____ Ft.
 Sand _____
 Gas _____
 Oil _____
 Total Depth _____

PRODUCTION


1st 24 hrs. Nat. _____
 1st 24 hrs. after shot _____
 Gas _____ Cu. Ft.
 Dry Hole _____
 Abandoned _____

Date 12/11, 1916 Cardiff Scout

Map No. _____ Sec. 28 Twp. 28 R. 4Well No. 1 Blood Farm _____Big Jerry Company _____

NORTH

WEST

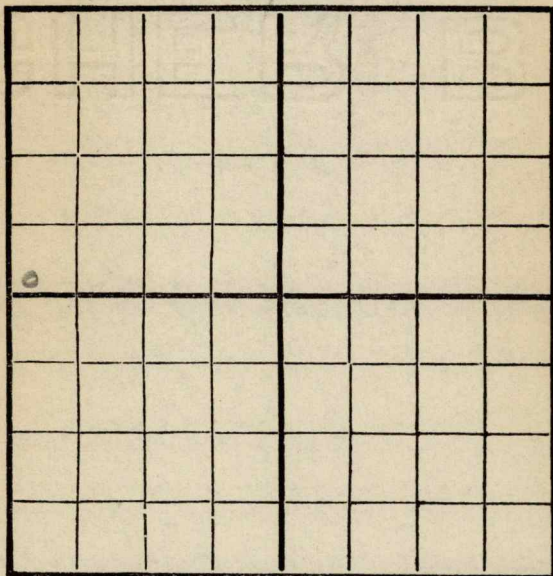

EAST

SOUTH

Location _____

Rig Up _____

Drilling and remarks

Shut Down
2620'

RECORD

Cased _____ in. _____ Ft.

Sand _____

Gas _____

Oil _____

Total Depth _____

PRODUCTION

1st 24 hrs. Nat. _____

1st 24 hrs. after shot _____

Gas _____ Cu. Ft.

Dry Hole _____

Abandoned _____

Date

12/18, 1916 Cardiff Scout

MAP NO. KANSAS SEC. 28 TWP. 28S R. 4E

WELL NO. 1 Blood

COMPANY Big Jerry

CONTRACTOR

SECTION PLAT

ABANDONED

FT. FROM N. LINE

FT. FROM S. LINE

FT. FROM E. LINE

FT. FROM W. LINE

LOCATION

RIG UP

DRILLING AND REMARKS:

RECORD

CASED IN. FT.

SAND

GAS

OIL

TOTAL DEPTH 2700

PRODUCTION

1ST 24 HRS. NAT.

1ST 24 HRS. AFTER SHOT

GAS Cu. Ft.

DRY HOLE

ABANDONED

DATE


12-27-16 192

SCOUT

Map No. _____ Sec. 28 Twp. 28 R. 4Well No. 13 Farm _____Big Jerry Oil Company _____

NORTH

WEST

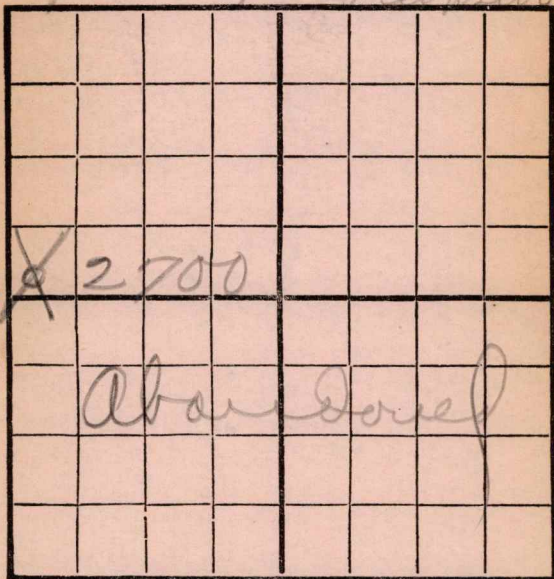

EAST

SOUTH

Location _____

Rig Up _____

Drilling and remarks

Plugged
at 2700

RECORD

Cased _____ in. _____ Ft.

Sand _____

Gas _____

Oil _____

Total Depth _____

PRODUCTION

1st 24 hrs. Nat. _____

First 24 hrs. after shot _____

Gas _____ Cu. Ft.

Dry Hole _____

Abandoned 2700

Date

12 Feb 6 Candij _____ Scout