


Map No. _____ Sec. 29 Twp. 28 R. 4
 Well No. 19 Blood Farm _____
Ohio Company _____

NORTH

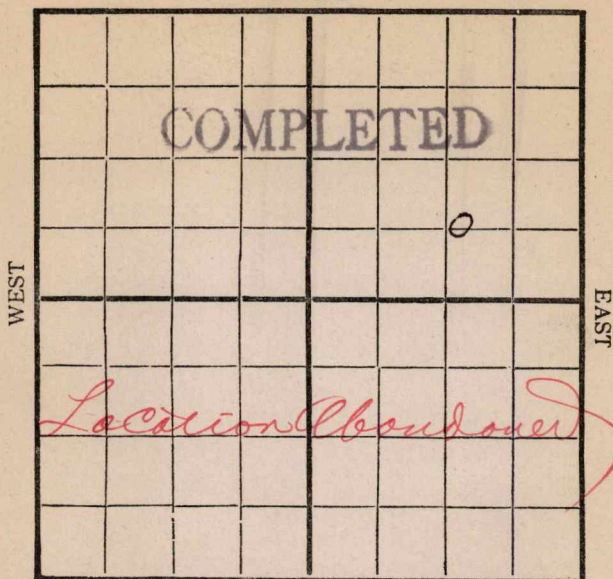

SOUTH

Location _____

Rig Up _____

Drilling Remarks:

Drilling Remarks:

RECORD

Cased _____ in _____ Ft.
 Sand _____
 Gas _____
 Oil _____
 Total Depth _____

PRODUCTION

1st 24 hrs. Nat. _____
 1st 24 hrs. after shot _____
 Gas _____ Cu. Ft.
 Dry Hole _____
 Abandoned _____

Map No. _____ Sec. 29 Twp. 28 R. 9

Well No. 1912404 Farm _____

----- Company

NORTH


SOUTH

Location _____

Rig Up ✓

Drilling and remarks

FIRST REPORT

RECORD

Cased-----in. -----Ft.

Sand-----

Gas _____

Oil

Total Depth_____

PRODUCTION

1st 24 hrs. Nat.-----

1st 24 hrs. after shot-----

Gas----- Cu. Ft.

Dry Hole_____

Abandoned_____

Date _____

2/5, 1912. *Cordell* Scout

Map No. _____ Sec. 29 Twp. 38 R. 4
Well No. 19 Blond Farm _____
Oliver Company _____

NORTH

[illegible]

SOUTH

Location _____
 Rig Up _____
 Drilling and remarks _____

RECORD

Cased _____ in. _____ Ft.
 Sand _____
 Gas _____
 Oil _____
 Total Depth _____


PRODUCTION

1st 24 hrs. Nat.
1st 24 hrs. after shot.....
Gas..... Cu. Ft.
Dry Hole.....
Abandoned.....

Date Feb 2, 1912 C. D. Jeff Scout

Map No. _____ Sec. 29 Twp. 28 R. 4
Well No. 1913 Farm _____
Oliver Company _____

NORTH

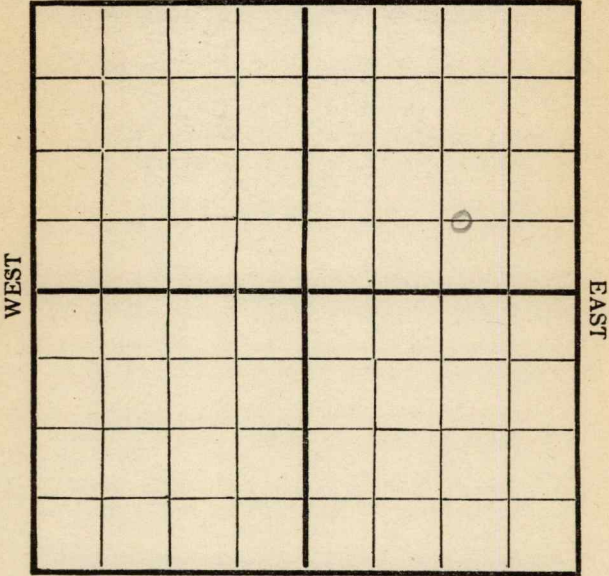

SOUTH


	RECORD
Location _____	Cased _____ in. _____ Ft.
Rig Up _____	Sand _____
Drilling and remarks _____	Gas _____
	Oil _____
	Total Depth _____
	PRODUCTION
	1st 24 hrs. Nat. _____
	1st 24 hrs. after shot _____
	Gas _____ Cu. Ft.
	Dry Hole _____
	Abandoned _____

Date Aug 7, 1917 Scout Carley

Map No. _____ Sec. 29 Twp. 28 R. 4
 Well No. 1913 Farm _____
Oliver Company _____

NORTH

WEST

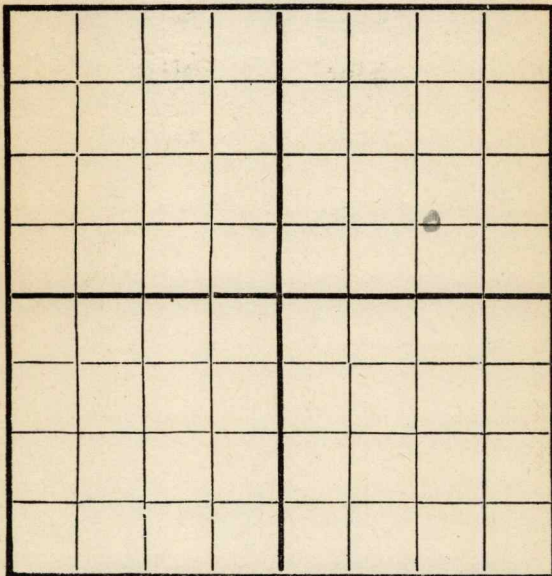

EAST

SOUTH

Location _____
 Rig Up ☒ _____
 Drilling and remarks _____

RECORD

Cased _____ in. _____ Ft.
 Sand _____
 Gas _____
 Oil _____
 Total Depth _____

PRODUCTION

1st 24 hrs. Nat. _____
 First 24 hrs. after shot _____
 Gas _____ Cu. Ft.
 Dry Hole _____
 Abandoned _____

Date

Feb 2, 1911 Carby Scout

Map No. _____ Sec. 29 Twp. 28 R. 4Well No. 191 Blend FarmOhio Company

NORTH

WEST EAST

SOUTH

REMARKS:

Rig


Date

3/5, 191 7 Cordell Scout

Map No. _____ Sec. 29 Twp. 28 R. 4
 Well No. 19 Blond Farm _____
Ohio Company _____

NORTH

WEST

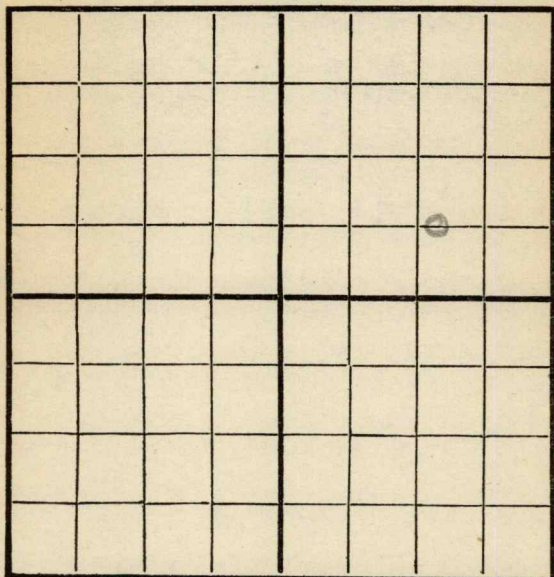

EAST

SOUTH

Location _____
 Rig Up ✓ _____
 Drilling and remarks _____

RECORD

Cased _____ in. _____ Ft.
 Sand _____
 Gas _____
 Oil _____
 Total Depth _____

PRODUCTION

1st 24 hrs. Nat. _____
 1st 24 hrs. after shot _____
 Gas _____ Cu. Ft.
 Dry Hole _____
 Abandoned _____

Date

3/12, 1917 C. D. J. Scout

Map No. _____ Sec. 29 Twp. 28 R. 4
 Well No. 19 Block Farm _____
Ohio Company _____

NORTH

WEST

EAST

SOUTH

Location _____
 Rig Up _____
 Drilling and remarks _____

RECORD

Cased _____ in. _____ Ft.
 Sand _____
 Gas _____
 Oil _____
 Total Depth _____

PRODUCTION

1st 24 hrs. Nat. _____
 1st 24 hrs. after shot _____
 Gas _____ Cu. Ft.
 Dry Hole _____
 Abandoned _____

Date


3/19 1917 Cardiff Scout

Map No. _____ Sec. 29 Twp. 28 R. 4
 Well No. 19 Blair Farm _____
 _____ Company _____

NORTH

WEST

EAST

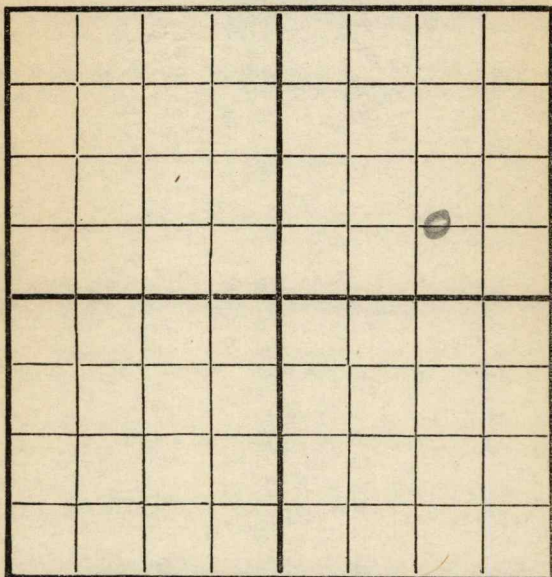

SOUTH

Location ✓Rig Up ✓

Drilling and remarks

RECORD

Cased _____ in. _____ Ft.

Sand _____

Gas _____

Oil _____

Total Depth _____

PRODUCTION

1st 24 hrs. Nat. _____

1st 24 hrs. after shot _____

Gas _____ Cu. Ft.

Dry Hole _____


Abandoned _____

Date

2/26, 1912 Carly Scout

Map No. _____ Sec. 29 Twp. 28 R. 4
 Well No. 1913 Farm _____
Ohio Company _____

NORTH

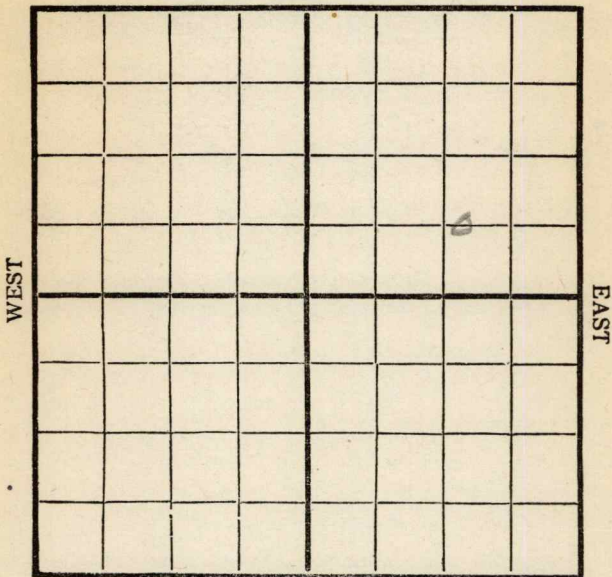

SOUTH

Location _____
 Rig Up _____
 Drilling and remarks _____

RECORD

Cased _____ in. _____ Ft.
 Sand _____
 Gas _____
 Oil _____
 Total Depth _____

PRODUCTION

1st 24 hrs. Nat. _____
 First 24 hrs. after shot _____
 Gas _____ Cu. Ft.
 Dry Hole _____
 Abandoned _____

Date


4/4, 1917 Carly Scout

Map No. _____ Sec. 29 Twp. 28 R 4
 Well No. 1913 Farm _____
Ohio Company _____

NORTH

WEST

EAST

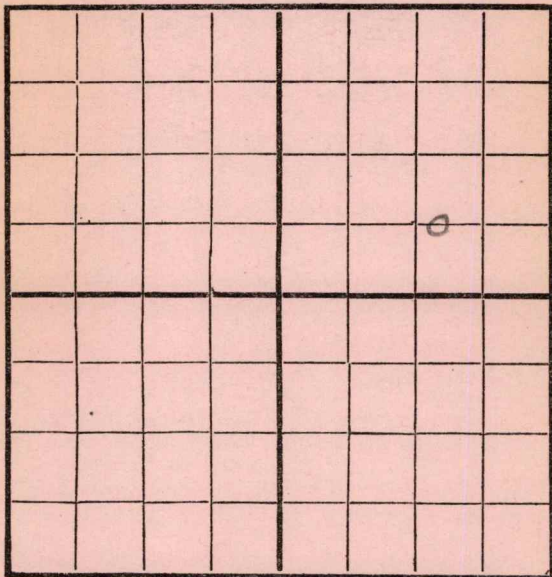

SOUTH

Location _____
 Rig Up ☒ _____
 Drilling and remarks _____

RECORD

Cased _____ in. _____ Ft.
 Sand _____
 Gas _____
 Oil _____
 Total Depth _____

PRODUCTION


1st 24 hrs. Nat. _____
 1st 24 hrs. after shot _____
 Gas _____ Cu. Ft.
 Dry Hole _____
 Abandoned _____

Date

4/10, 1917 Cardiff Scout

Map No. _____ Sec. 29 Twp. 28 R. 4
 Well No. 1913 Farm _____
Ohio Company _____

NORTH

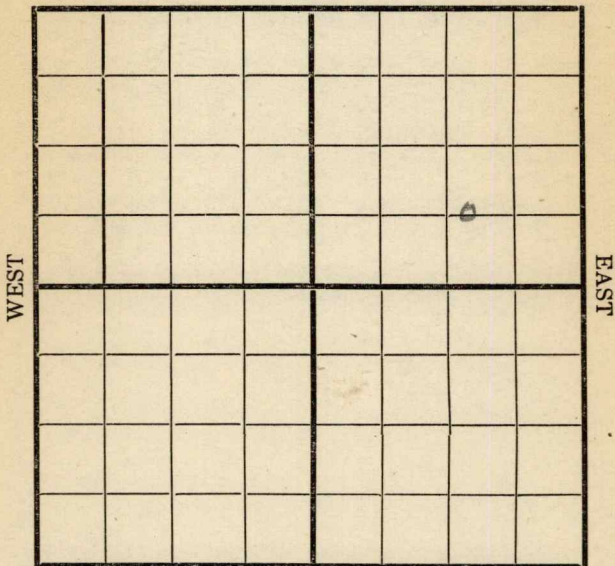

SOUTH

Location _____
 Rig Up ☒ _____
 Drilling and remarks _____

RECORD

Cased _____ in. _____ Ft.
 Sand _____
 Gas _____
 Oil _____
 Total Depth _____

PRODUCTION


1st 24 hrs. Nat. _____
 1st 24 hrs. after shot _____
 Gas _____ Cu. Ft.
 Dry Hole _____
 Abandoned _____

Date

4/17, 1917 Candiff Scout

Map No. _____ Sec. 29 Twp. 28 R. 4
 Well No. 19 Blue Farm _____
Oliver Company _____

NORTH

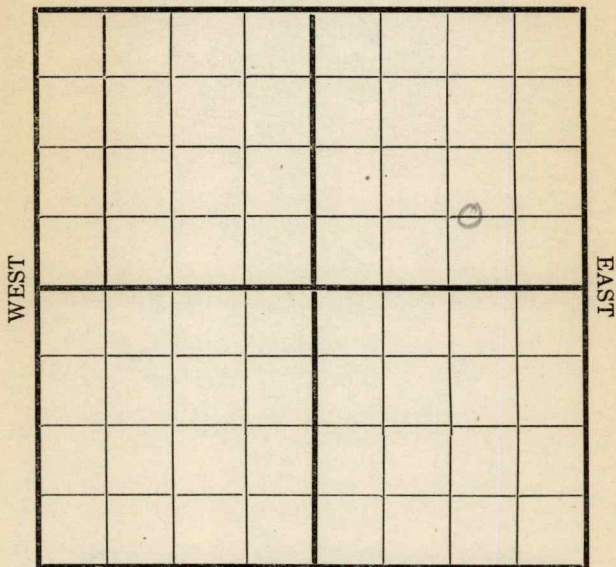

SOUTH

Location _____ Rig Up _____ Drilling and remarks _____	RECORD
	Cased _____ in. _____ Ft.
	Sand _____
	Gas _____
	Oil _____
	Total Depth _____
	PRODUCTION
	1st 24 hrs. Nat. _____
	1st 24 hrs. after shot _____
	Gas _____ Cu. Ft.
	Dry Hole _____
	Abandoned _____

Date 4/24, 1917 Carley Scout

Map No. _____ Sec. 29 Twp. 28 R. 4
Well No. 1913 _____ Farm _____
Olin _____ Company _____

NORTH

WEST

EAST

SOUTH

Location _____

Rig Up _____

Drilling and remarks

RECORD

Cased_____in. _____Ft.

Sand_____

Gas _____

Oil _____

Total Depth_____

PRODUCTION

1st 24 hrs. Nat. _____

1st 24 hrs. after shot-----

Gas_____Cu. Ft.

Dry Hole_____

Abandoned_ _ _ _ _


Date _____

5/2, 1917 Curley Scout

Map No. _____ Sec. 29 Twp. 38 R. 4
 Well No. 19 Blom Farm _____
Oliver Company _____

NORTH

WEST

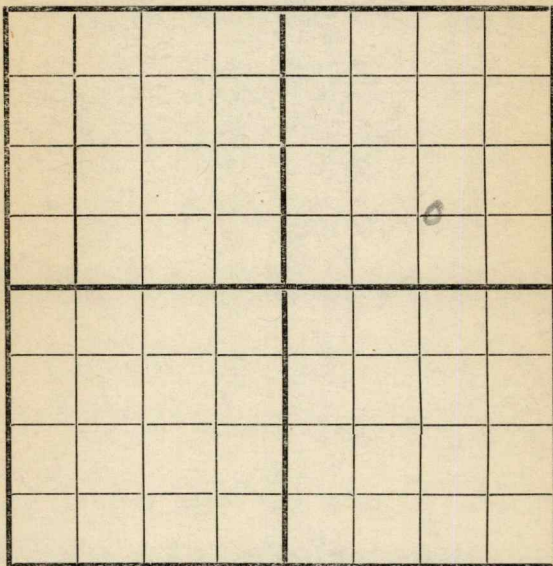

EAST

SOUTH

Location _____
 Rig Up ☒ _____
 Drilling and remarks _____

RECORD

Cased _____ in. _____ Ft.
 Sand _____
 Gas _____
 Oil _____
 Total Depth _____

PRODUCTION

1st 24 hrs. Nat. _____
 1st 24 hrs. after shot _____
 Gas _____ Cu. Ft.
 Dry Hole _____
 Abandoned _____


Date

5/8, 191 7 Carley Scout

Map No. _____ Sec. 29 Twp. 28 R. 4
 Well No. 1913 Farm _____
Oliver Company _____

NORTH

WEST

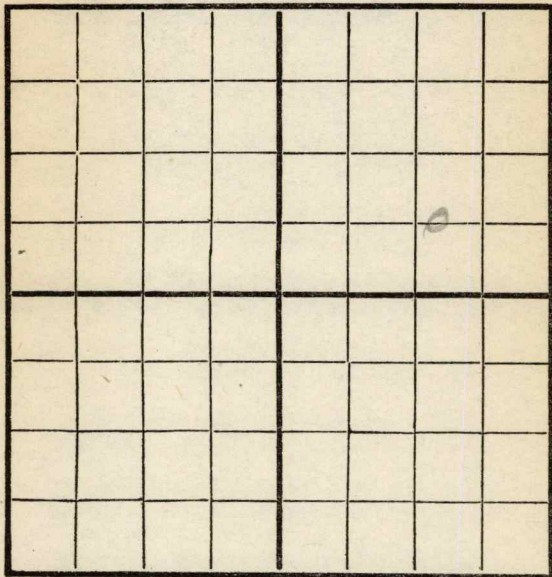

EAST

SOUTH

Location _____
 Rig Up _____
 Drilling and remarks _____

RECORD

Cased _____ in. _____ Ft.
 Sand _____
 Gas _____
 Oil _____
 Total Depth _____

PRODUCTION


1st 24 hrs. Nat. _____
 1st 24 hrs. after shot _____
 Gas _____ Cu. Ft.
 Dry Hole _____
 Abandoned _____

Date

5/25, 1917 Carley Scout

Map No. _____ Sec. 29 Twp. 28 R. 4
 Well No. 19 Bled Farm _____
Olin Company _____

NORTH

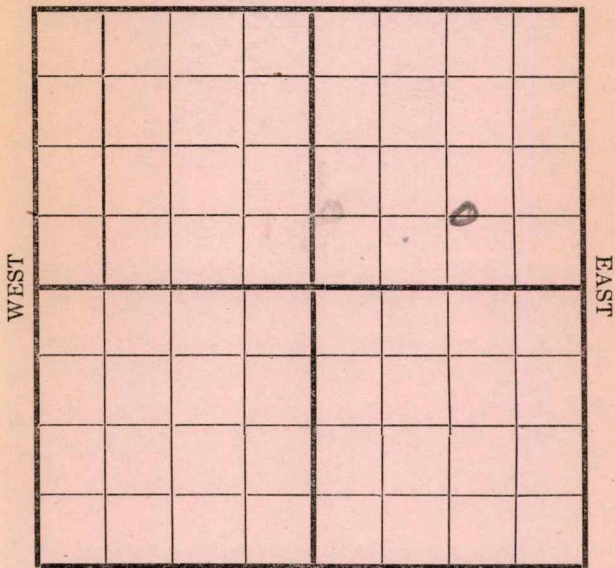

SOUTH

Location _____
 Rig Up ☒ _____
 Drilling and remarks _____

RECORD

Cased _____ in. _____ Ft.
 Sand _____
 Gas _____
 Oil _____
 Total Depth _____

PRODUCTION

1st 24 hrs. Nat. _____
 1st 24 hrs. after shot _____
 Gas _____ Cu. Ft.
 Dry Hole _____
 Abandoned _____


Date

3/29, 1917 Scout

Map No. _____ Sec. 29 Twp. 28 R. 4
 Well No. 1913 Farm _____
Blair Company _____

NORTH

WEST

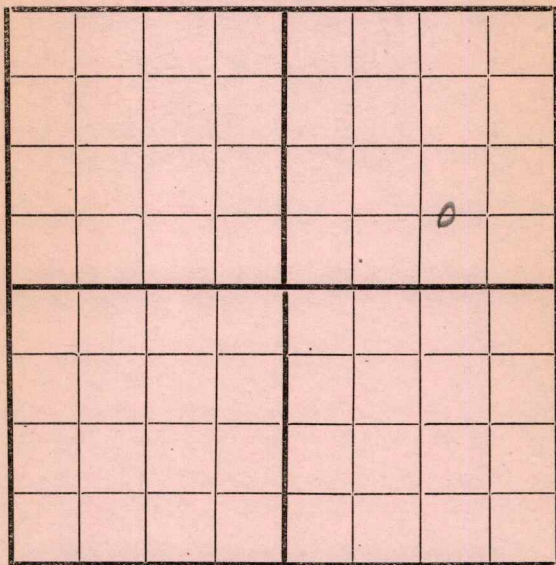

EAST

SOUTH

Location _____
 Rig Up _____
 Drilling and remarks _____

RECORD

Cased _____ in. _____ Ft.
 Sand _____
 Gas _____
 Oil _____
 Total Depth _____

PRODUCTION

1st 24 hrs. Nat. _____
 1st 24 hrs. after shot _____
 Gas _____ Cu. Ft.
 Dry Hole _____
 Abandoned _____


Date

6/8, 1917 Carley Scout

Map No. _____ Sec. 29 Twp. 28 R. 4
 Well No. 19 Bear Farm _____
Oliver Company _____

NORTH

WEST

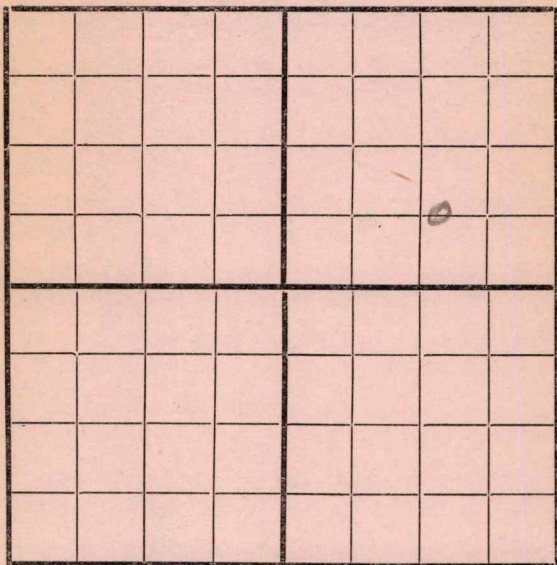

EAST

SOUTH

Location _____
 Rig Up _____
 Drilling and remarks _____

RECORD

Cased _____ in. _____ Ft.
 Sand _____
 Gas _____
 Oil _____
 Total Depth _____

PRODUCTION

1st 24 hrs. Nat. _____
 1st 24 hrs. after shot _____
 Gas _____ Cu. Ft. _____
 Dry Hole _____
 Abandoned _____

Date


6/12, 1912 Cardiff Scout

Map No. _____ Sec. 29 Twp. 28 R. 4
 Well No. 191300 Farm _____
Ohio Company _____

NORTH

WEST

EAST

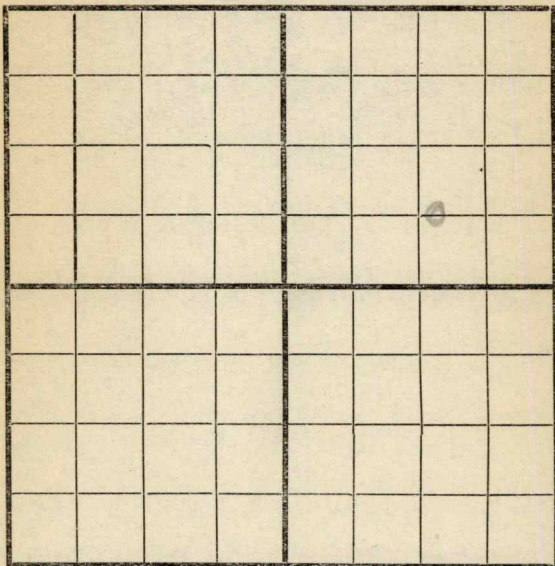

SOUTH

Location _____

Rig Up _____

Drilling and remarks _____

RECORD

Cased _____ in. _____ Ft.

Sand _____

Gas _____

Oil _____

Total Depth _____

PRODUCTION

1st 24 hrs. Nat. _____

1st 24 hrs. after shot _____

Gas _____ Cu. Ft.

Dry Hole _____


Abandoned _____

Date

6/20, 1917 Cordiff Scout

Map No. _____ Sec. 29 Twp. 28 R. 4
 Well No. 19 Bloss Farm _____
Ohio Company _____

NORTH

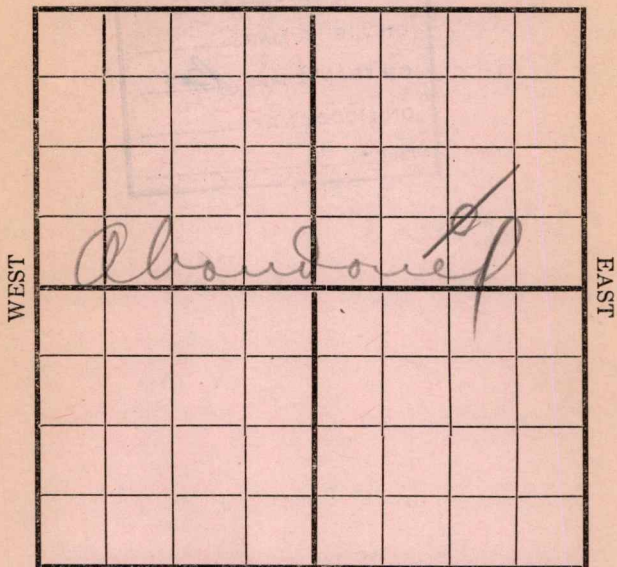

SOUTH

Location _____

Rig Up _____

Drilling and remarks

RECORD

Cased _____ in. _____ Ft.

Sand _____

Gas _____

Oil _____

Total Depth _____

PRODUCTION

1st 24 hrs. Nat. _____

1st 24 hrs. after shot _____

Gas _____ Cu. Ft.

Dry Hole _____

Abandoned _____

Date

6/27, 1917 C. S. G. Co. Scout

MAP NO. K11 KANSAS SEC. 29 TWP. 28S R. 4E

WELL NO. 19 Blood

Mid-Kansas COMPANY

CONTRACTOR

SECTION PLAT

ABANDONED

_____ FT. FROM N. LINE

_____ FT. FROM S. LINE

_____ FT. FROM E. LINE

_____ FT. FROM W. LINE

LOCATION ✓

RIG UP ✓

DRILLING AND REMARKS:

Red

RECORD

CASED _____ IN. _____ FT.

SAND _____

GAS _____

OIL _____

TOTAL DEPTH _____

PRODUCTION

1ST 24 HRS. NAT. _____

1ST 24 HRS. AFTER SHOT _____

GAS _____ CU. FT.

DRY HOLE _____

ABANDONED ✓

DATE

June 27 1927

SCOUT