


Section 19 Township 15 Range 17W

Well No. 5 Dumler

Company Peel-Hardman

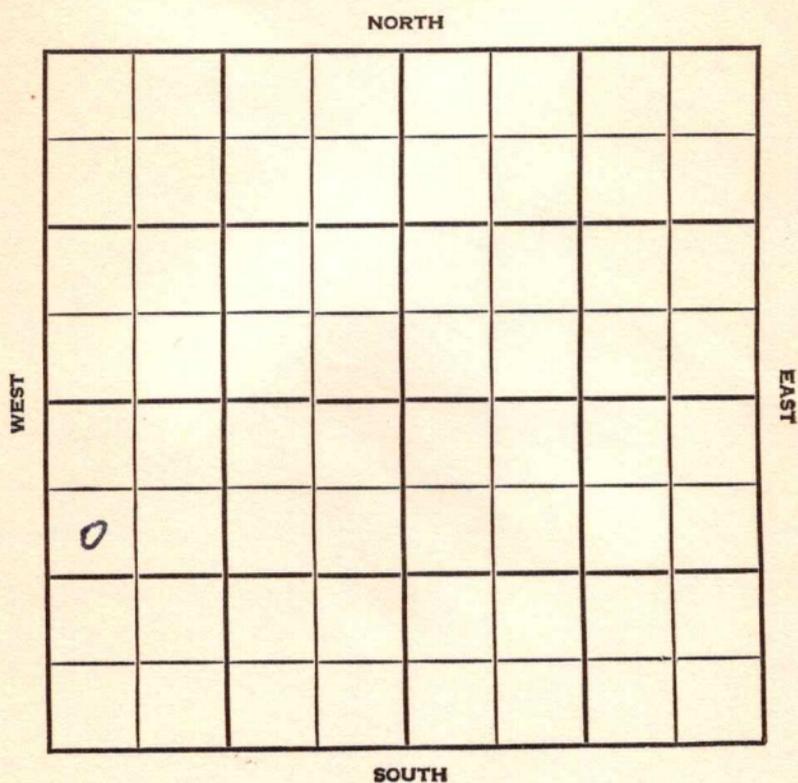

SEC.	TWP.	R.
19	15	17W

WELL NO. #5 Dumler FARM

COMPANY Peel-Hardman

CONTRACTOR Glen Peel


SW Wheatland Pool

990 Ft. from N. Line

Ft. from S. Line

Ft. from E. Line

330 Ft. from W. Line

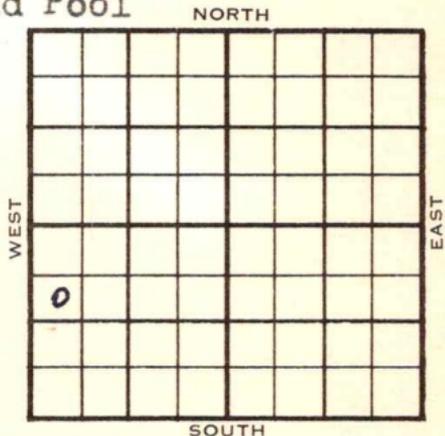

SW NW SW

1955	ELEVATION	REPORT
	2010'	

3/9 R UR
 5/25 Heeb 3254; Lsg 3305; Arb 3577;
 TD 3577;
 8 5/8" 1180; RTD 3577; 5 1/2" 3572;
 CO 3577; 500 A; 3 boph; Phy pmp
 149 bopd no wtr. from Arb 3572-77

COMPLETED

