

KANSAS


Form 51-5M-7-40-Palace

Cowley

Section 13 Township 30 Range 5-E

Well No. #4 Hunsaker

Company Ryan Consolidated

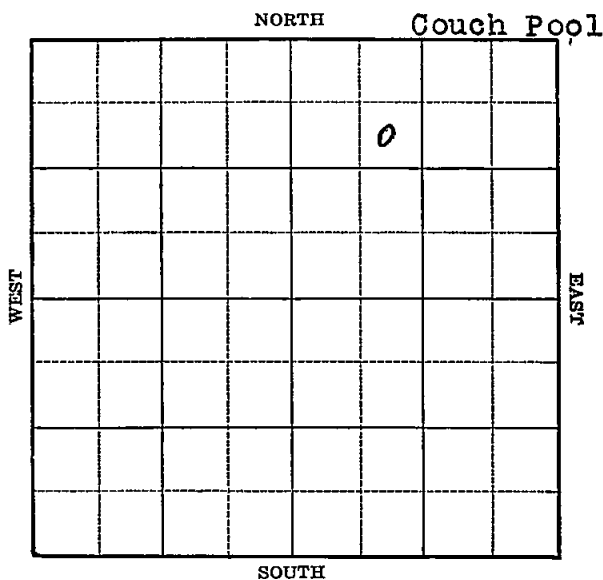

KANSAS

Cowley

Sec. 13 Twp. 30 R. 5-EWell No. #4 Hunsaker FarmRyan Consolidated Company


(Couch)

990 Ft. from N. Line990 Ft. from S. Line

Ft. from E. Line

990
990 Ft. from W. Line

Elev. 1350

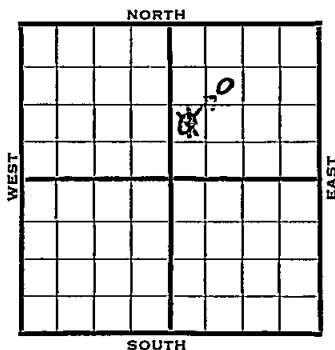

1941	REPORT
1/22	Drilg. 1000'
1/30	Bart. 2812-32' T.D. 7" - 2812' WOC.
2/6	" "
2/13	" "
2/20	T.D. 2840' 135 qts. H.F.O. Shut down.
2/27	" "
3/6	" "
3/13	" "
3/20	" "
3/26	Bart. 2812' 7" - 2812' T.D. 2840' Shot 135 qts. Potential 309 bbls., pump. 37. Gravity
	COMPLETED

Map No. 11 Sec. 13 Twp. 30 R. 5EWell No. 4 Hunsaker

Ryan Consolidated

Company

FIRST REPORT

Contractor

NW SW NE

 Ft. from N. Line990 Ft. from S. Line Ft. from E. Line330 Ft. from W. Line

SECTION PLAT

		o	

COUCH POOL

Location Rig up

Drilling and Remarks:

Drlg. 1000

RECORD

Cased in., ft.Sand Gas Oil Total Depth

PRODUCTION

1st 24 hrs. Nat. 1st 24 hrs. after shot Gas Cu. Ft.Dry Hole Abandoned

Date

JAN 22 1941

19

J. LEWIS Scout

Map No. 11 Sec. 13 Twp. 30 ~~26~~ R. 5EWell No. 4 HunsakerRyan Consolidated CompanyCORRECTION Contractor**SECTION PLAT**

SE NW NE

990 Ft. from N. Line Ft. from S. Line Ft. from E. Line990 Ft. from W. Line

		o	

COUCH POOL

Location Rig up

Drilling and Remarks:

Reported

NW SW NE

RECORDCased in., ft.Sand Gas Oil Total Depth **PRODUCTION**1st 24 hrs. Nat. 1st 24 hrs. after shot Gas Cu. Ft.Dry Hole Abandoned

Date

JAN 29 1941S. J. LEWIS Scout

Map No. // Sec. 13 Twp. 30 R. 5EWell No. 4 HunsakerRyan Consolidated Company/ Contractor**COMPLETED****SECTION PLAT**

SE NW NE

990 Ft. from N. Line Ft. from S. Line Ft. from E. Line990 Ft. from W. Line

COUCH POOL

Location Rig up

Drilling and Remarks:

*Bar 2812.**7" @ 2812.**1359 ft**Pump 309 Pst**37° Gr.***RECORD**Cased in., ft.Sand Gas Oil Total Depth 2840**PRODUCTION**1st 24 hrs. Nat. 1st 24 hrs. after shot Gas Cu. Ft.Dry Hole Abandoned

Date

MAR 26 1941 19S. J. LEWIS Scout