

Map No. _____ Sec. 28 Twp. 28 R. 4Well No. 1-Pawn Lot Farm _____Van Arsdale Trucking Co. Company

NORTH



SOUTH

Location ✓ ✓

Drilling Remarks:

Rig Up 11-17-161-8-17
Drilling Remarks:

RECORD

Cased _____ in _____ Ft.

Sand _____

Gas _____

Oil _____

Total Depth _____

PRODUCTION


1st 24 hrs. Nat. _____

1st 24 hrs. after shot _____

Gas _____ Cu. Ft.

Dry Hole _____

Abandoned _____

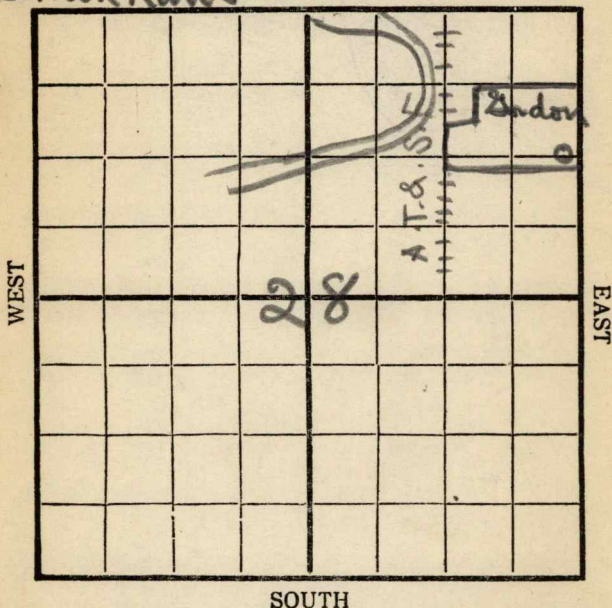Map No. 3 Sec. 28 Twp. 28 R. 4Well No. 1 Town Lot 135X150 FarmThe Van Arsdale-Marshall CompanyGordon Kans' NORTH Well GasLocation yes

Rig Up

Drilling and remarks

Town lot
135X150
known as
Rape

RECORD

Cased _____ in. _____ Ft.

Sand _____

Gas _____

Oil _____

Total Depth _____

PRODUCTION

1st 24 hrs. Nat. _____

First 24 hrs. after shot _____

Gas _____ Cu. Ft.

Dry Hole _____

Abandoned _____


Date

11-17, 1916 Goofus Scout

Map No. _____ Sec. 28 Twp. 28 R. 4Well No. 1 at River Lot FarmGardner Trussite Company

NORTH

WEST

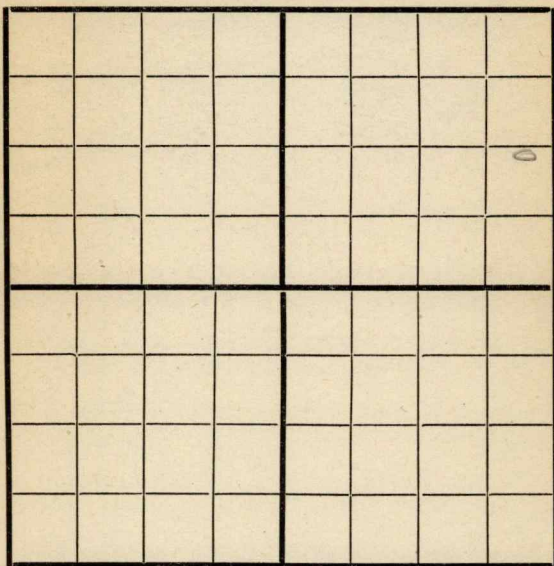

EAST

SOUTH

Location _____

Rig Up ☒ _____

Drilling and remarks _____

RECORD

Cased _____ in. _____ Ft.

Sand _____

Gas _____

Oil _____

Total Depth _____

PRODUCTION

1st 24 hrs. Nat. _____

1st 24 hrs. after shot _____

Gas _____ Cu. Ft.

Dry Hole _____

Abandoned _____


Date

1/8, 191 2 Cordell Scout

1002 K11
 Map No. _____ Sec. 28 Twp. 28 R. 4
 Well No. 1. Atkins Lot.
 Harden Sonns Co. Company
 Contractor _____

NORTH

WEST

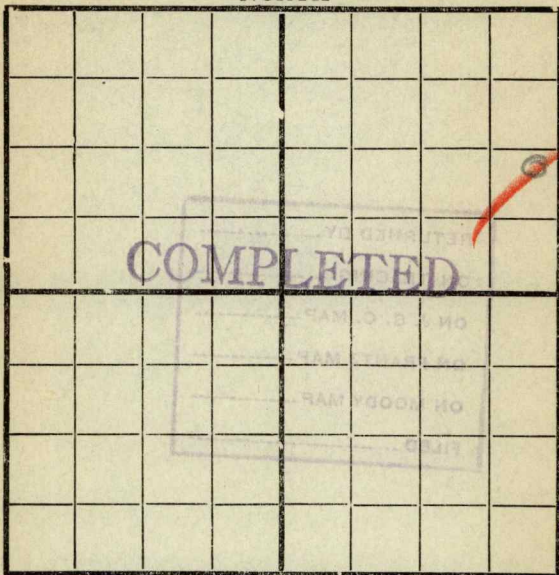

EAST

SOUTH

Location _____

Rig up _____

Drilling and Remarks:

RECORD

Cased _____ in., _____ ft.

Sand _____

Gas _____

Oil _____

Total Depth _____

PRODUCTION

1st 24 hrs. Nat. _____

1st 24 hrs. after shot _____

Gas _____ Cu. Ft.

Dry Hole _____

Abandoned _____

Date

1/8 1917 Cardiff Scout