

Russell

KANSAS

Section 25 Township 15 Range 14 W

Well No. # 13 Mollie

Company Gulf Oil

NORTH

WEST

EAST

SOUTH

Russell

KANSAS ✓

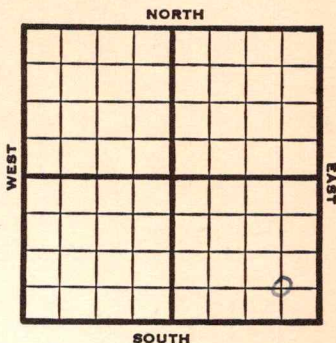
Sec. 25 Twp. 15 R. 14WWell No. #13 Mollie FarmGulf Oil CompanyBarbour Drlg. ContractorTrapp Pool

Ft. from N. Line

660 Ft. from S. Line660 Ft. from E. Line

Ft. from W. Line

C SE SE

1953 **Elev. 1867'** REPORT

6/3 Spud 5-28-53

8" @ 857'

Anhy 850'

WOC

6/10 **Heeb 2991, Tor 3011, Lans 3061,****Arb 3301**

RTD 3303

6/24 No report

7/1 Spud 5-28-53 Oil well TD 3306

8" @ 857' **Anhy 850' Heeb 3301**

TD 3303 7" @ 3302 CO to 3303

FU 110' oil 1 hr. B/5 BOPH 2 hr.

DD 3304 S/7 BOPH DD 3304 S/19 BO

S/5 BO DD 3306 S/5 BOPH 1 BW

Comp. 32 BOPD 48 BW

COMPLETED

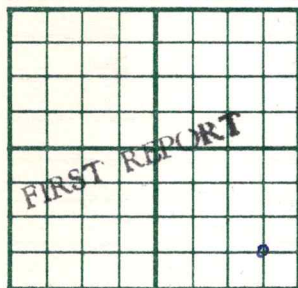
County Russell State Kansas
 Sec. 25 (Blk. 15 (Sur. 14W Map No.
 (Twp.) (Rge.)
 Operator Gulf Oil
 Well No. 13 Farm Mollie
 Elev. 1867 Location C SE SE



660 Ft. From S Line SE
660 Ft. From E Line Quarter
 1st. Report JUL 1 1953
 Completion
 Remarks Trapp Pool
Barbour - Contr.
 Spudding Date 5-28-53

Drlg. Data Oil well TD 3306
8" @ 857 Anhy 850 Heeb. 2991
Tor. 3011 Lans. 3061 Arb. 3301
TD 3303 7" @ 3302 CO to 3303
FU 110' oil 1 hr. B/ 5 boph 2 hr.
DD 3304 S/ 7 boph DD 3304 S/ 19 bo
S/ 5 bo DD 3306 S/ 5 boph 1 bw
Comp. 32 bopd 48 bw

J. G. McGEHEE

County Russell State KansasSec. 25 (Blk. 15) (Sur. 14W) Map No.Operator Gulf OilWell No. 13 Farm MollieElev. Location C SE SE660 Ft. From S Line SE660 Ft. From E Line Quarter1st. Report JUN 3 1953

Completion

Remarks

Barbour Drlg. - Contr.Spudding Date 5-28-53Drlg. Data Trapp Pool8" @ 857 Anhy 850 WOC