

# KANSAS

Form 51-5M-7-40-Palace


Cowley

Section 13 Township 30 Range 5-E

Well No. #1 Marble Savings Bank

Company Ryan Consolidated

NORTH Miscellaneous

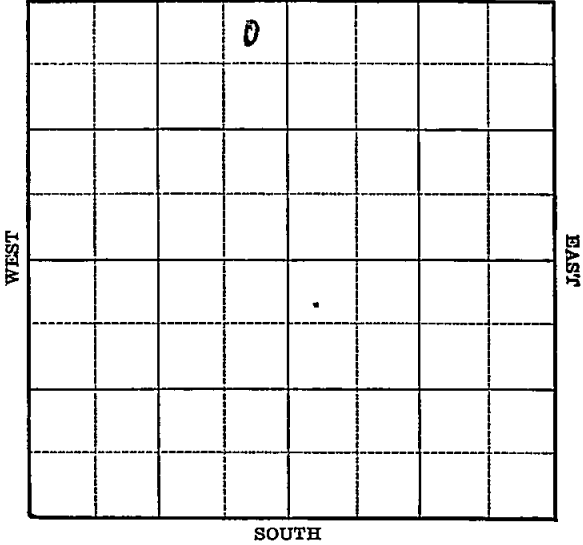

Sec. 13 Twp. 30 R. 5-E

Well No. #1 Marble Savings Farm

Ryan Consolidated Company

(Misc.)


330 Ft. from N. Line

\_\_\_\_\_ Ft. from S. Line

330 Ft. from E. Line

\_\_\_\_\_ Ft. from W. Line

Elev. 1344

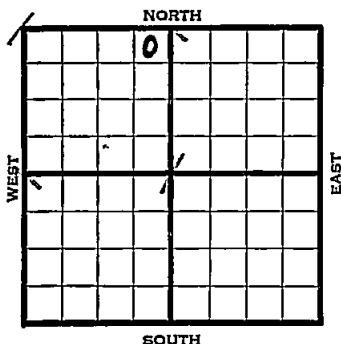

| 1940      |  | REPORT                     |
|-----------|--|----------------------------|
| 9/4       |  | Derrick.                   |
| 9/12      |  | Rigging up.                |
| 9/19      |  | 13" - 95'                  |
|           |  | SD 1950'                   |
| 9/26      |  | Bart. 2804-38' T.D. S.O.   |
|           |  | 7" - 2786' WOC.            |
| 10/3      |  | " " "                      |
| 10/10     |  | " " "                      |
| 10/17     |  | " " "                      |
| 10/24     |  | " " "                      |
| 10/31     |  | " " "                      |
| 11/6      |  | Bart. 2804'                |
|           |  | 7" - 2786'                 |
|           |  | T.D. 2838'                 |
|           |  | Potential 520 bbls., pump. |
| COMPLETED |  |                            |

Map No. 11 Sec. 13 Twp. 30 R. 5EWell No. 1 Marble SavingsRyan Consolidated

Company

Contractor

**FIRST REPORT**

NE NW

330 Ft. from N. Line

Ft. from S. Line

330 Ft. from E. Line

Ft. from W. Line

**SECTION PLAT**

|  |  |  |  |
|--|--|--|--|
|  |  |  |  |
|  |  |  |  |
|  |  |  |  |
|  |  |  |  |

**MISCELLANEOUS**

Location \_\_\_\_\_

Rig up \_\_\_\_\_

Drilling and Remarks:

**Derrick****RECORD**

Cased \_\_\_\_\_ in., \_\_\_\_\_ ft.

Sand \_\_\_\_\_

Gas \_\_\_\_\_

Oil \_\_\_\_\_

Total Depth \_\_\_\_\_

**PRODUCTION**

1st 24 hrs. Nat. \_\_\_\_\_

1st 24 hrs. after shot \_\_\_\_\_

Gas \_\_\_\_\_ Cu. Ft.

Dry Hole \_\_\_\_\_

Abandoned \_\_\_\_\_

Date

SEP 4 1940S. J. LEWIS

Scout

Map No. 11 Sec. 13 Twp. 30 R. 5E

Well No. 1 Marble Savings

Ryan Consolidated Company

Contractor

**COMPLETED**

NE NW

330 Ft. from N. Line

\_\_\_\_\_ Ft. from S. Line

330 Ft. from E. Line

\_\_\_\_\_ Ft. from W. Line

**SECTION PLAT**

|  |  |  |  |
|--|--|--|--|
|  |  |  |  |
|  |  |  |  |
|  |  |  |  |
|  |  |  |  |

**MISCELLANEOUS**

Location \_\_\_\_\_

Rig up \_\_\_\_\_

Drilling and Remarks:

*Bar 2804  
7" C 2776.  
Pump 520 128.*

**RECORD**

Cased \_\_\_\_\_ in., \_\_\_\_\_ ft.

Sand \_\_\_\_\_

Gas \_\_\_\_\_

Oil \_\_\_\_\_

Total Depth 28.35

**PRODUCTION**

1st 24 hrs. Nat. \_\_\_\_\_

1st 24 hrs. after shot \_\_\_\_\_

Gas \_\_\_\_\_ Cu. Ft.

Dry Hole \_\_\_\_\_

Abandoned \_\_\_\_\_

Date

NOV 6 1940 19 \_\_\_\_\_

S. J. LEWIS Scout