


Cowley county

Section 13 Township 30 Range 5-E

Well No. #1, ~~Boatman~~ 1/1/son

Company E. B. Shawver

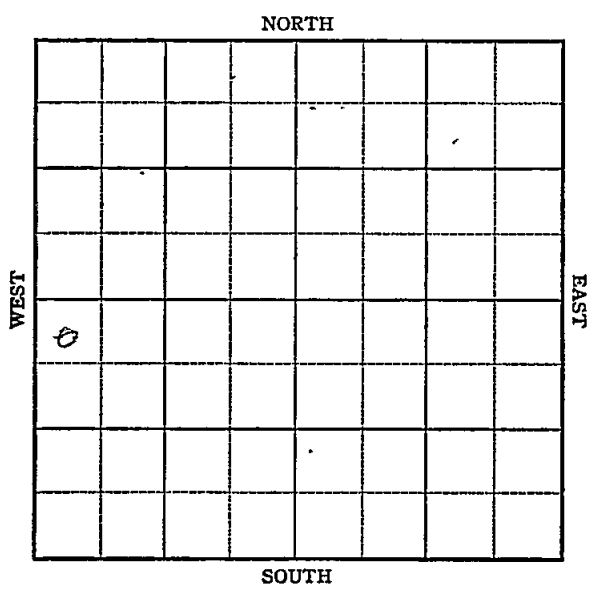

KANSAS

Sec. 13 Twp. 30 R. 5-E

Well No. #1, Bostin Farm

E. B. Shawter

Company


Miscellaneous

330' Ft. from N. Line

\_\_\_\_\_ Ft. from S. Line

\_\_\_\_\_ Ft. from E. Line

330' Ft. from W. Line

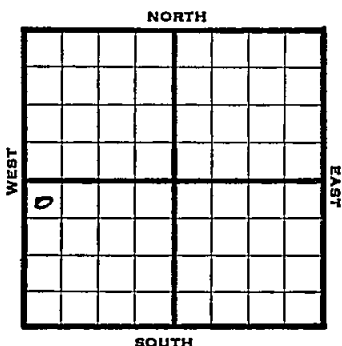

NW SW

| 1946  | REPORT                            |
|-------|-----------------------------------|
|       | Elev. 1335                        |
| 12/4  | Location                          |
| 12/10 | RUR                               |
| 12/17 | 10" @ 45'<br>Drlg 1100'           |
| 1947  |                                   |
| 1/4   | Bart 2819'<br>TD 2821'<br>Run 7"  |
| 1/8   | 7" @ 2821', RUST                  |
| 1/15  | TD 2887'<br>70 qts CO             |
| 1/21  | Pump 5 oil to 20 W PH<br>Squeeze  |
| 2/5   | Bart 2819<br>TD 2887<br>7" @ 2121 |
|       | ABANDONED                         |

Map No. 11 Sec. 13 Twp. 30 R. 5E

Well No. 1 Bostin

E. B. Shawber Company

**FIRST REPORT** Contractor

NW SW


**SECTION PLAT**

330 Ft. from N. Line

         Ft. from S. Line

         Ft. from E. Line

330 Ft. from W. Line

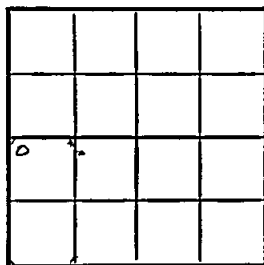

Cowley County

Location X

Rig up         

Drilling and Remarks:

**RECORD**

Cased          in.,          ft.

Sand         

Gas         

Oil         

Total Depth         

**PRODUCTION**

1st 24 hrs. Nat.         

1st 24 hrs. after shot         

Gas          Cu. Ft.

Dry Hole         

Abandoned         

Date

DEC 4 1946 19 S. J. LEWIS Scout

Map No. 11 Sec. 13 Twp. 30 R. 5EWell No. 1 WilsonE. B. Shawver

Company

**CORRECTION**

Contractor

NW SW

**SECTION PLAT**

|   |  |  |  |
|---|--|--|--|
|   |  |  |  |
|   |  |  |  |
| * |  |  |  |
|   |  |  |  |

330 Ft. from N. Line       Ft. from S. Line       Ft. from E. Line330 Ft. from W. Line

Cowley County

Location                     Rig up                     

Drilling and Remarks:

Reported .

#1 Bostin

**RECORD**Cased            in.,            ft.Sand                     Gas                     Oil                     Total Depth                     **PRODUCTION**1st 24 hrs. Nat.                     1st 24 hrs. after shot                     Gas                      Cu. Ft.Dry Hole                     Abandoned                     

Date

JAN 8 1947 19

S. J. LEWIS Scout

Map No. 11 Sec. 13 Twp. 30 R. 5E

Well No. 1 Wilson

E. B. Shawver Company

**ABANDONED**

Contractor

NW SW

*E/1,1335*  
**SECTION PLAT**

330 Ft. from N. Line

       Ft. from S. Line

       Ft. from E. Line

330 Ft. from W. Line

|   |  |  |  |
|---|--|--|--|
|   |  |  |  |
|   |  |  |  |
| o |  |  |  |
|   |  |  |  |

Cowley County

Location                     

Rig up                     

Drilling and Remarks:

*Bar Y2519*  
*7" @ 254*

**RECORD**

Cased        in.,        ft.

Sand                     

Gas                     

Oil                     

Total Depth 2587

**PRODUCTION**

1st 24 hrs. Nat.                     

1st 24 hrs. after shot                     

Gas                      Cu. Ft.

Dry Hole                     

Abandoned                     

Date

FEB 5 1947 19 S. J. LEWIS Scout