

KANSAS


FORM 51 5M 6-46 PETROL

Cowley County

Section 14 Township 30 Range 5E

Well No. 3 Sandstrum "B"

Company Ed Adair

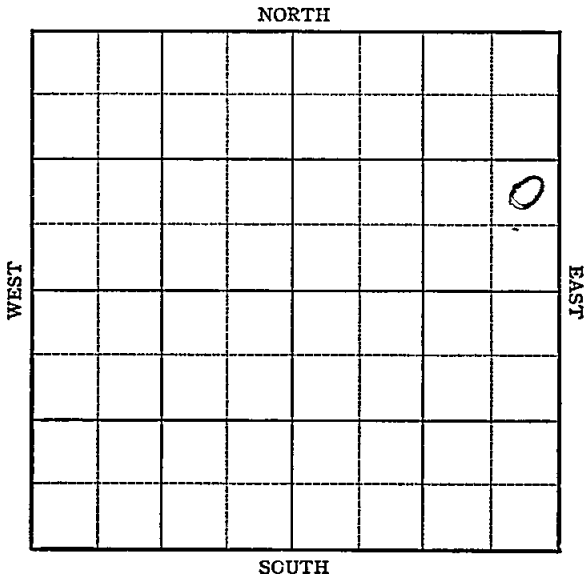

KANSAS

Cowley County



Sec. 14 Twp. 30 R. 5E

Well No. #3 Sandstrum "B" Farm

Ed Adair Company

Miscellaneous


 Ft. from N. Line

990 Ft. from S. Line

330 Ft. from E. Line

 Ft. from W. Line

NE SE NE

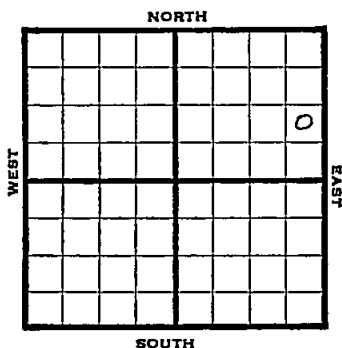

1946 1326 REPORT

7/31 Location

8/6 8" @ 102
Drlg 1390'

8/13 Bart 2786-
2787 TD
5" @ 2787 RUST

8/20 TD 2831-2000' oil
70 qts 2791-2826 CO

8/27 " " "

9/5 " " "

9/11 Bart 2786
5" @ 2787'
TD 2831'
70 qts.
Pump 50 oil plus 33% wtr. Pot.
Gravity 40°

COMPLETED

KANSAS

Kansas Pool Name MiscellaneousMap No. 14 Sec. 30 Twp. 5EWell No. 3 Sandstrum "B"Ed Adair CompanyFIRST REPORT Contractor

NE SE NE

SECTION PLAT

			0

 Ft. from N. Line990 Ft. from S. Line330 Ft. from E. Line Ft. from W. Line

Cowley County

RECORD

Location XCased in, ft.Sand Gas Oil Total Depth Rig up

Drilling and Remarks:

PRODUCTION

1st 24 hrs. Nat. 1st 24 hrs. after shot Gas Cu. Ft.Dry Hole Abandoned

Date

JUL 3 1 1946 19 S. J. LEWIS Scout

Kansas Pool Name MiscellaneousMap No. 11 Sec. 14 Twp. 30 R. 5EWell No. 3 Sandstrum "B"

Ed Adair _____ Company

COMPLETED

Contractor

NE SE NE

E1,1326
SECTION PLAT

_____ Ft. from N. Line

990 Ft. from S. Line330 Ft. from E. Line

_____ Ft. from W. Line

			6

Cowley County**RECORD**

Location _____

Cased _____ in., _____ ft.

Rig up _____

Sand _____

Drilling and Remarks:

Gas _____

Oil _____

Total Depth 2831**PRODUCTION**

1st 24 hrs. Nat. _____

1st 24 hrs. after shot _____

Gas _____ Cu. Ft.

Dry Hole _____

Abandoned _____

Date

SEP 11 1946 19S. J. LEWIS Scout

Bar 2786
 5' @ 2787
 709 lb.
 Pump 50 oil +
 63% N Bx
 402 lb