


Section 22 ²⁹ Township 28 Range 4E

Well No. #2 Buvonel

Company Maryln oil C.L. Brosius

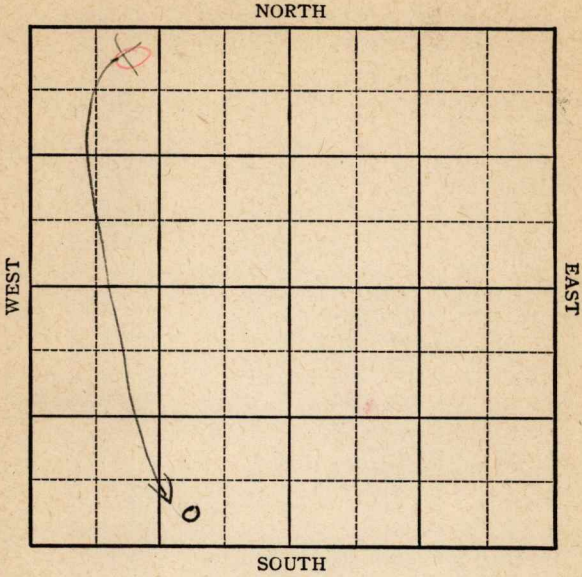

KANSAS

Butler County

Sec. 39 Twp. 28 R. 4E

Well No. #2 Buvonel Farm

Maryln Oil C.L. Brosius Company


Miscellaneous

~~360~~ Ft. from N. Line

330 Ft. from S. Line

990 Ft. from E. Line

990 Ft. from W. Line

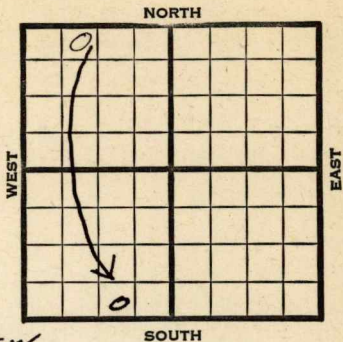

~~NE NW~~ NW SW SE SW

1945

Elev. 1247 REPORT

- 3/28 Machine
- 4/5 Spud
- 4/12 Drlg. 480'
- 4/20 Drlg. 500'
- 4/27 13" @ 485
- Drlg. 805'
- 5/3 10" @ 1012
- Drlg. 1095
- 5/10 Drlg. 1670
- 5/17 **KC** 2062
- 6" @ 2068 TD
- 5/24 **Arb** 2526-2529
- TD 2529 SO
- 6/6 **Arb. 2519**
- 6" @ 2068
- TD 2521
- Pump 200 Pot.
- Grav. 38.7

COMPLETED

Pool Name Miscellaneous

Map No. 11 Sec. 32 Twp. 28 R. 4E

Well No. 2 Buvonel

Maryln oil Company

FIRST REPORT Contractor

NE NW NW

SECTION PLAT

0			

330 Ft. from N. Line

_____ Ft. from S. Line

_____ Ft. from E. Line

990 Ft. from W. Line

Butler

Location _____

Rig up _____

Drilling and Remarks:

machine

RECORD

Cased _____ in., _____ ft.

Sand _____

Gas _____

Oil _____

Total Depth _____

PRODUCTION

1st 24 hrs. Nat. _____

1st 24 hrs. after shot _____

Gas _____ Cu. Ft.

Dry Hole _____

Abandoned _____

Date

MAR 28 1945 19

S. J. LEWIS Scout

Kansas Pool Name Miscellaneous

Map No. 11 Sec. 29 Twp. 28 R. 4E

Well No. 2 Buvozel

Marylyn Oil Company

CORRECTION Contractor

SW SE SW

SECTION PLAT

_____ Ft. from N. Line

330 Ft. from S. Line

990 Ft. from E. Line

_____ Ft. from W. Line

Butler

Location _____

Rig up _____

Drilling and Remarks:

reported

32-28-4E

NE NW NW

RECORD

Cased _____ in., _____ ft.

Sand _____

Gas _____

Oil _____

Total Depth _____

PRODUCTION

1st 24 hrs. Nat. _____

1st 24 hrs. after shot _____

Gas _____ Cu. Ft.

Dry Hole _____

Abandoned _____

Date

APR 11 1945 19 _____

S. J. LEWIS Scout

Kansas Pool Name Miscellaneous

Map No. 11 Sec. 29 Twp. 28 R. 4E

Well No. 2 Buyonel

C. L. Brosius Company

(COMPLETED) Contractor

SW SE SW

E1.1247
SECTION PLAT

 Ft. from N. Line

330 Ft. from S. Line

990 Ft. from E. Line

 Ft. from W. Line

Butler County

Location

Rig up

Drilling and Remarks:

*Per 82519
6" @ 2068*

Pump 200 ft

38 3/4

RECORD

Cased in., ft.

Sand

Gas

Oil

Total Depth 2521

PRODUCTION

1st 24 hrs. Nat.

1st 24 hrs. after shot

Gas Cu. Ft.

Dry Hole

Abandoned

Date

JUN 6 1945 19

S. J. LEWIS Scout