

DX 78-1


Cowley

KANSAS

Section 15 Township 30 Range 5E

Well No. #1 Holt Cowley

Company Wrico Drlg

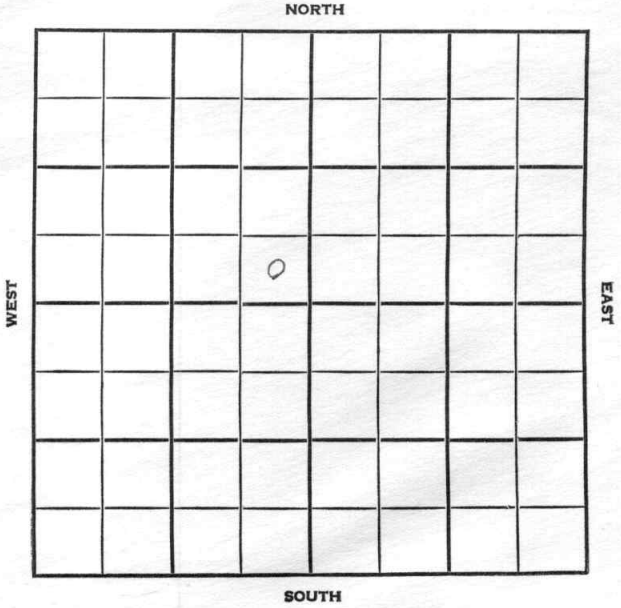

Cowley

KANSAS

SEC. <i>15 17</i>	TWP. 30	R. 5E
----------------------	------------	----------


WELL NO. #1 Holt *Donley* FARM

COMPANY Wrico Drlg.

CONTRACTOR Co. tools

Wildcat

_____ FT. FROM N. LINE
 _____ FT. FROM S. LINE
 _____ FT. FROM E. LINE
 _____ FT. FROM W. LINE

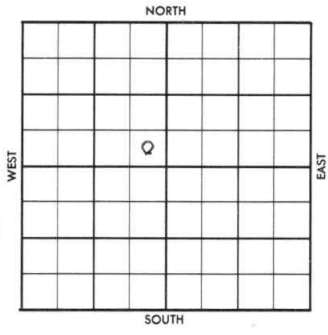

SE SE NW

1956	ELEVATION 1309'	REPORT
------	-----------------	--------

6-27 Location

7-18 Comm. 7-1-56
 8 5/8" @ 183 w/125
 D & A
 Stall. 1912'; Li. 2256'; BKC 2514';
 Peru Zn. 2612'; Ft. Sct. 2638';
 Ce. 2732'; Bartl. Zn 2860'; M.Chert 2929'
 M. Dolo 2953';
 TD 2966'

ABANDONED

County Cowley Elev. _____
 Sec. 15 Twp. 30 Rge. 5E
 Company Wrico Drilling
 Farm Name Holt No. 1

TOPS	DEPTH	LOG	DATUM
Anh.			
Tp.			
H.			
Tr.			
Dg.			
Bl.			
L.			
K.C.			
B.K.C.			
Ce.			
C.			
M.			
M.			
K.			
Mz.			
Mq.			
V.			
S.			
S.			
A.			
R.			
Pe.			
G.			
T.D.			

Loc. in Sec. SE SE NW
 Geol. _____
 Contr. Co. tools
 Pool Wildcat
 FIRST REPORT
 JUN 27 '56

Date Comm. _____
 Location _____

282

CORRECTION

FORM 513 SUNRAY

County Cowley Elev. 1309 Co.
 Sec. 25 17 Twp. 30 Rge. 5E
 Company Wrico Drilling
 Farm Name Holt Donley No. 1

TOPS	DEPTH	LOG	DATUM	Loc. in Sec.
Anb.				SE SE NW
Tp.				
H. <u>Stall</u>	<u>1912</u>			
Tr.				
Dg.				
Bl.				
L.				Geol.
K.C. <u>Li</u>	<u>2256</u>			
R.K.C.	<u>2514</u>			Contr.
C. <u>Peru Zn</u>	<u>2612</u>			Co. tools
G. <u>Et set</u>	<u>2638</u>			
M. <u>ce</u>	<u>2732</u>			Pool
M. <u>Bart Zn</u>	<u>2860</u>			Wildcat
K. <u>Michet</u>	<u>2929</u>			
Mz. <u>M Dolo</u>	<u>2953</u>			
Ma.				
V.				
S.				
S.				
A.				
R.				
PE.				
G.				
T.D.	<u>2966</u>			JUL 18 1956

Date Comm. _____

Location JUL 5 '56 JUL 11 '56 7-1-56

8 5/8 183 1125 Ø 2707 JUL 18 '56

DEA

Co.

Lse.

No.

Sec.

T.

R.