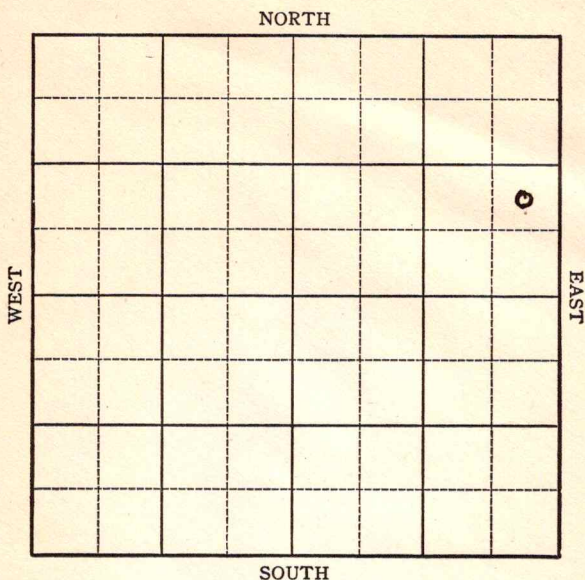


KANSAS

Russell county

Section 26 Township 15 Range 14-WWell No. #12, Bender "A"Company Cities Service Oil Company

KANSAS

Russell

Sec. 26 Twp. 15-S R. 14-W

Well No. #12 Bender "A" Farm

Cities Service

Company


Ft. from N. Line

990' Ft. from S. Line

330' Ft. from E. Line

Ft. from W. Line

NE SE NE

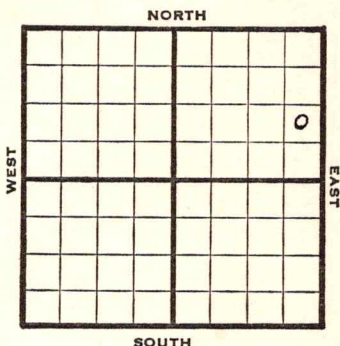

1946

REPORT

Elev. 1897'

9/5

Location

9/10

8" @ 350

Drlg 2100'

9/18

Arb 3338

TD 3340'

4" @ 3339 RUST

9/24

TD 3347

Pump 87 oil 12hrs

10/1

Arb 3338'

4" @ 3339'

TD 3347'

Pump 195 POT

Grav 40.9

COMPLETED

KANSAS Kansas Pool Name Trapp PoolMap No. 73 Sec. 26 Twp. 15 R. 14WWell No. 12 Bender "A"Cities Service Company
COMPLETED

NE SE NE

E11897
SECTION PLAT

			0

 Ft. from N. Line990 Ft. from S. Line330 Ft. from E. Line Ft. from W. LineRussell CountyLocation Rig up

Drilling and Remarks:

Art 33384" @ 3338Aug 19584038**RECORD**Cased in., ft.Sand Gas Oil Total Depth 3247**PRODUCTION**1st 24 hrs. Nat. 1st 24 hrs. after shot Gas Cu. Ft.Dry Hole Abandoned

Date

OCT 2 1946 19S. J. LEWIS Scout

KANSAS Kansas Pool Name Trapp

Map No. 73 Sec. 26 Twp. 15 R. 14W

Well No. 12 Bender "A"

Cities Service Company

FIRST REPORT Contractor

NE SE NE

SECTION PLAT

 Ft. from N. Line

990 Ft. from S. Line

330 Ft. from E. Line

 Ft. from W. Line

			o

Russell County

Location X

Rig up

Drilling and Remarks:

RECORD

Cased in., ft.

Sand

Gas

Oil

Total Depth

PRODUCTION

1st 24 hrs. Nat.

1st 24 hrs. after shot

Gas Cu. Ft.

Dry Hole

Abandoned

Date

SEP 5 1946 19

S. J. LEWIS Scout