


Section 12 Township 27 Range 13 W

Well No. # 6 K. Beck

Company Magnolia Pet.

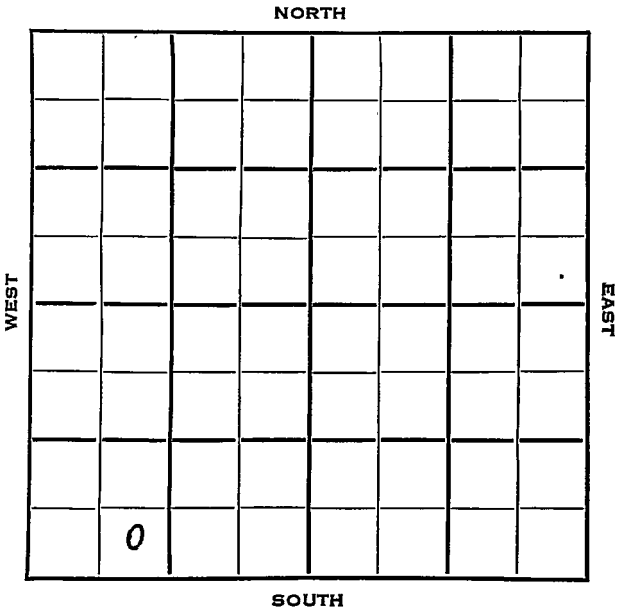

SEC.	TWP.	R.
12	27	13W ✓

WELL NO. #6 K. Beck FARM

COMPANY Magnolia Pet.

CONTRACTOR


Iuka-Garmi Pool

_____ Ft. from N. Line

330 _____ Ft. from S. Line

_____ Ft. from E. Line

990 _____ Ft. from W. Line

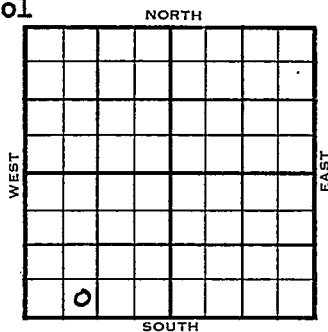

SE SW SW

1953	ELEVATION	REPORT
	1897'	

- 9/9 Location
- 9/16 9" @ 695' w/500 sks
- 9/23 DrLg 3495'
- 9/30 Heb 3539' Br 11 3715' Lans 3729'
Miss 4176' V 4215'
DrLg. 4277'
- 10/7 Simp 4283,
DST 4281'-4301' 1 hr, 120' oil, 90'
mco, 30' HO&GCM, 863#
DST 4312'-51' 1 hr, 5' socm, 60' SW,
1175# Arb 4404'
NS
RTD 4407
5" @ 4406'
- 10/14 CO 4370 16/ 4310-14 $\frac{1}{4}$ bwph / sso
5 hrs. Hyd. S/ 80 bo 18 hrs. S/ 21
bo / 7 bw 8 hrs. FU 1300' fluid 12
hrs PB 4302 44/ 4284-95 S/ 21
bo 6 hrs. Hyd.
- 10/21 S/ 57 bo / 62 BW 16 hrs. 500 A S/ 6
bo / 48 BW 8 hrs. Sq. CO 4297 44/
4284-95 1 go / 3 gwph 8 hrs. Hyd.

1953

#6 K. Beck

- 10/28 S/ 52 BO 16 hrs. CO 4370'
S/ 1 $\frac{1}{2}$ boph 16 hrs.
16/ 4310-14
- 11/4 P/ 25 BO / 42 BW 24 hrs.
- 11/11 Spud 9-12-53
Oil Well
TD 4407'
9" @ 695'
Heeb 3539', Br. lime 3715', Lans
3729', Miss 4176', Viola 4215', Simp
4283'
DST 4281-4301, opn 1 hr., rec. 120'
oil, 90' mco, 30' ho & gcm, 863#
DST 4312-51, opn 1 hr., rec. 5' socm,
60' sw, 1175#
Arb. 4402'
TD 4407'
5" @ 4406'
CO to 4370, 16/4310-14, $\frac{1}{4}$ bwph & SSO
5 hrs.
Hydro.
S/80 bo 18 hrs.
S/21 bo 7 bw 8 hrs.
FU 1300' fluid 12 hrs.
PB 4302, 44/4284-95,
S/21 bo 6 hrs.
Hydro.
S/57 bo 6 bw 16 hrs., 500A
S/6 bo 48 bw 8 hrs.
CO to 4297
44/4284-95, 1 go 3 gwph 8 hrs.
Hydro.
S/52 bo 16 hrs.
CO to 4370
S/1 $\frac{1}{2}$ boph 16 hrs.
16/4310-14, P/25 bo 42 bw 24 hrs.
P/21 bo 31 bw 24 hrs.
Comp. 28 bopd 42 bw

COMPLETED

Dirig. Data

CO to 4370 S/ $1\frac{1}{2}$ boph 16 hr.

16/ 4310-14 P/ 25 bo 42 bw 24 hr.

P/ 21 bo 31 bw 24 hr.

Comp. 28 bopd 42 bw

Recd. 9/11

MON 9/11

Scout Cards

Land Grant Ward

Land Grant Ward

Tracing

France Map

France Map