KANSAS

DX 78-1

Kingman

Section 18 Township 30 Range 7 W

Well No. # 1 E. Johnson

Company Amerada Petroleum

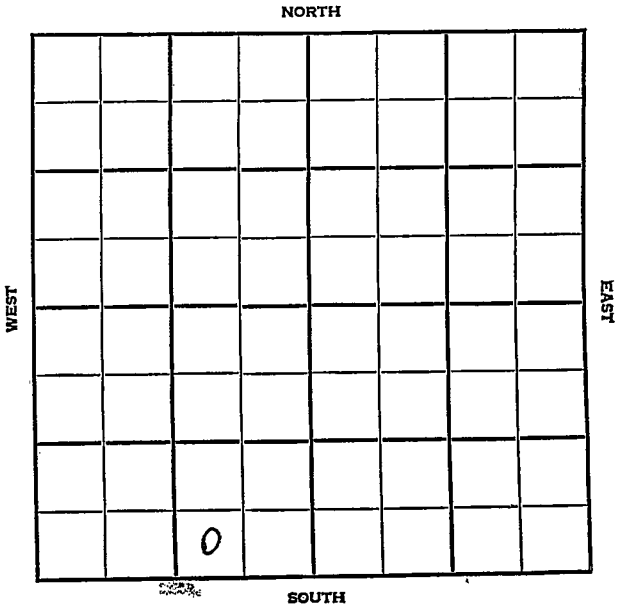

Kingman KANSAS

SEC.	TWP.	R.
18	30	7W

WELL NO. #1 E. Johnson FARM

COMPANY Amerada Pet.

CONTRACTOR D& M

E. Spivey Pool

330 Ft. from S. Line

990 Ft. from E. Line

Ft. from N. Line

Ft. from W. Line

SW SE SW

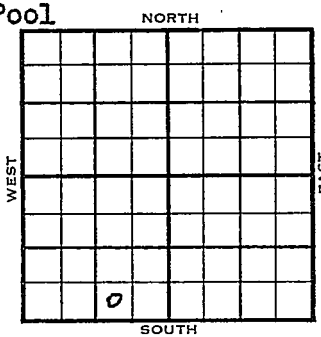

1955	ELEVATION 1536'	REPORT

1/5 Location

2/9 Spud 1-6-55 SI gas well.
TD 4390' 8" @ 206 Heeb 3166
Doug 3217' Lans 3398'
DST 3740-55, open 1 hr rec 1620' SW 1370# Miss 4182
DST 4183-4202 open 2 hr, gas in 5 min 80,000 CFG 174' GCM 1575#
DST 4203-21 open 2 hr gas in 5 min, 90,000 CFG 179' GCM 1575#
Miss 4220'
DST 4254-4307, open 1 hr rec 80' drlg. mud. 275#
DST 4319-40 open 2 hr, rec 90' HOCM 920' oil 930' wtr. 1450#
DST 4340-55 open 2 hr rec 500' oil 1910# wtr. 1430# TD 4390'
5" @ 4388 112/4270-98 500 A
B/2 GO 72 GW 8 hr. A-frac.
S/57 BO 183 BW 11 hr.
S/7 BO 22 BW 5 hr. Perf/4222-42
250 A S/7½ BF 80% oil 7 hr.
A-frac. S/6 BO 43 BW 620,000 CFG
12 hr. SP 4218 40/4206-16 A-frac.
F/gas in 45 min. 18,100,000 CFG
6,150,000 CFG Comp. shut in gas well
3,129,000 CFGPD

COMPLETED

DX-78

FORM 275 FOR SALE BY KANSAS BLUE PRINT CO.

County Kingman State Kansas

Sec. 18 (Blk. Twp.) 30 (Sur. Rge.) 7W Map No.

Operator Amerada Petroleum

Well No. 1 Farm E. Johnson

Elev. Location SW SE SW



330 Ft. From S Line SW

990 Ft. From E Line Quarter

1st. Report JAN 5 1955

Completion

Remarks D & M - Contr.

Spudding Date

Drlg. Data E. Spivey Pool

Location

FABEN GILSTRAP

FORM 275 FOR SALE BY KANSAS BLUE PRINT CO.

County Kingman State Kansas

Sec. 18 (Blk. Twp.) 30 (Sur. Rge.) 7W Map No.

Operator Amerada Pet.

Well No. 1 Farm E. Johnson

Elev. 1536 Location SW SE SW

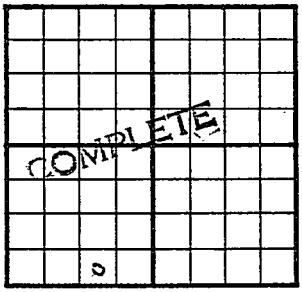

330 Ft. From S Line SW

990 Ft. From E Line Quarter

1st. Report

Completion FEB 9 1955

Remarks E. Spivey Pool

D & M - Contr.

Spudding Date 1-6-55

Drlg. Data SI gas well TD 4390

8" @ 206 Heeb. 3166 Doug. 3217

Lans. 3398 DST 3740-55 open 1 hr.

Rec. 1620' sw 1370# Miss. 4182

DST 4183-4202 open 2 hr. gas in 5 min.

80,000 cfg 174' gcm 1575# DST 4203-21

open 2 hr. gas in 5 min. 90,000 cfg

179' gcm 1575# Miss. 4220 DST 4254-

4307 open 1 hr. Rec. 80' drlg. mud

275# DST 4319-40 open 2 hr. Rec. 90'

hocm 920' oil 930' wtr. 1450#

DST 4340-55 open 2 hr. Rec. 500' oil

1910' wtr. 1430# TD 4390 5" @ 4388

112/ 4270-98 500 A B/ 2 go 72 gw 8 hr

A-frac S/ 57 bo 183 bw 11 hr.

OVER

FABEN GILSTRAP

Drlg. Data

S/ 7 bo 22 bw 5 hr. perf/ 4222-42

250 A S/ 7½ bf 80% oil 7 hr. A-frac

S/ 6 bo 43 bw 620,000 cfg 12 hr.

SP 4218 40/ 4206-16 A-frac F/ gas in

45 min. 18,100,000 cfg 6,150,000 cfg

Comp. shut in gas well 3,129,000 cfgpd

