

KANSAS

Form 51—5M—7-40—Palace


Russell

Section 26 Township 15 Range 14-W

Well No. #2 Eichman "B"

Company Cities Service Oil

Trapp Pool

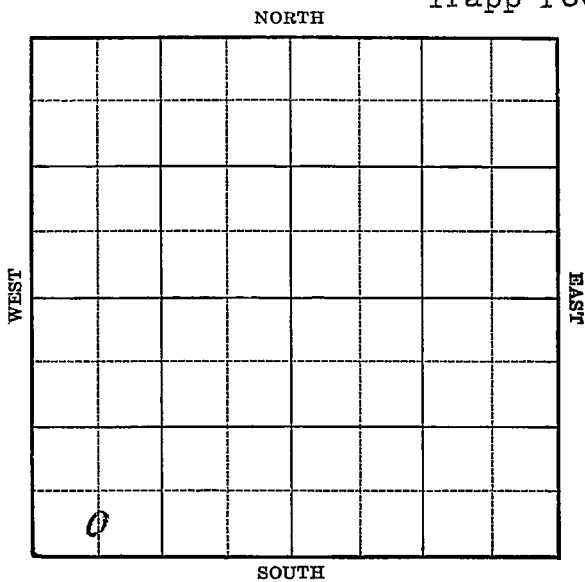


Sec. 26 Twp. 15 R. 14-WWell No. #2 Eichman "B" FarmCities Service Oil Company

(Trapp)

 Ft. from N. Line330 Ft. from S. Line Ft. from E. Line660 Ft. from W. Line

Elev. 1920

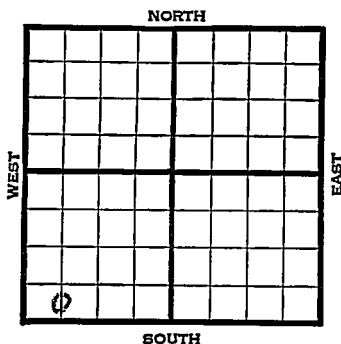

1940.

REPORT

10/23 8" - 348' WOC.

10/31 Drlg. 2460'

11/7 Arb. ³³⁶⁰~~3365~~' 5" - ³³⁶⁰~~3365~~' RUST.

11/14 Arb. 3360' (Corrected)

5" - 3360' T.D. 3366' 2900'

oil. 3000 acid.

11/20 Arb. 3360'

5" - 3360'

T.D. 3366'

3000 acid.

Depthograph potential 988 bbls.

40. Gravity

COMPLETED

Map No. 73 Sec. 26 Twp. 15 R. 14WWell No. 2 Eichman "B"

Cities Service Oil

Company

Contractor

FIRST REPORT

SECTION PLAT

C S L SW SW

Ft. from N. Line

330 Ft. from S. Line

Ft. from E. Line

660 Ft. from W. Line

TRAPP POOL

Location _____

Rig up _____

Drilling and Remarks:

8" - 348 WOC

RECORD

Cased _____ in., _____ ft.

Sand _____

Gas _____

Oil _____

Total Depth _____

PRODUCTION

1st 24 hrs. Nat. _____

1st 24 hrs. after shot _____

Gas _____ Cu. Ft.

Dry Hole _____

Abandoned _____

Date

OCT 23 1940 19

S J LEWIS Scout

Map No. 73 Sec. 26 Twp. 15 R. 14WWell No. 2 Eichman "B"Cities Service Oil Company

Contractor

COMPLETED

C S L SW SW

SECTION PLAT

 Ft. from N. Line330 Ft. from S. Line Ft. from E. Line660 Ft. from W. Line

TRAPP POOL

Location Rig up

Drilling and Remarks:

Ch & 3360
5" @ 3360
2000 acid
Depth 2898
40° gravity

RECORDCased in., ft.Sand Gas Oil Total Depth 3366**PRODUCTION**1st 24 hrs. Nat. 1st 24 hrs. after shot Gas Cu. Ft.Dry Hole Abandoned

Date

NOV 20 1940

S. J. LEWIS Scout