


Section 26 Township 15 Range 14<sup>2</sup>W

Well No. #3, Eichman QB

Company Cities Service Oil Company

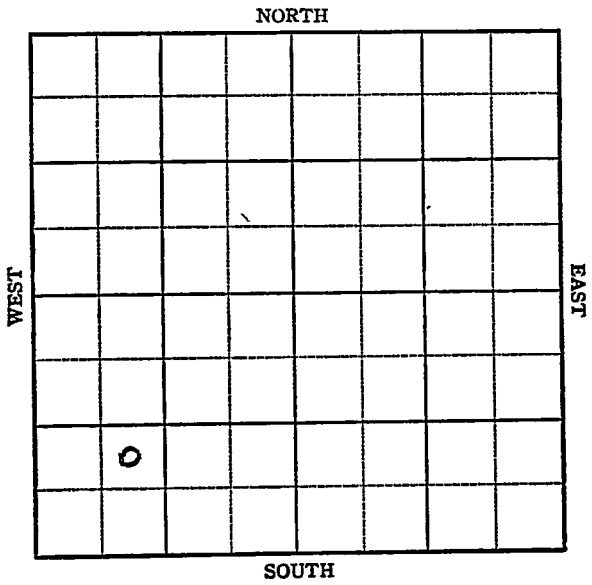

KANSAS

Russell

Sec. 26 Twp. 15 R. 14-W

Well No. #3, Eichman "B" Farm


Cities Service Oil Company Company  
Trapp Pool

\_\_\_\_\_ Ft. from N. Line

990' Ft. from S. Line

\_\_\_\_\_ Ft. from E. Line

990' Ft. from W. Line

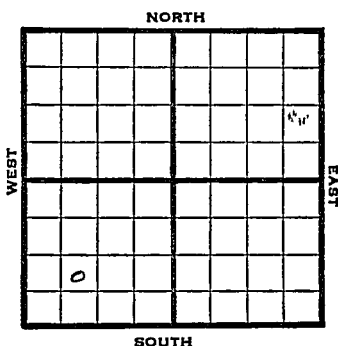

NE SW SW

REPORT	
1947	Elev. 1918
1/22	8" @ 372' WOC
1/30	Drlg 2620'
2/5	Arb 3378-80 TD 3380' 4" @ 3379 RUST
2/12	TD 3378' Arb 3373 Corrected 4" @ 3374' 500 acid
2/19	Pump 36 bbls oil & 12 W in 24 hrs
2/26	" "
3/4	" "
3/11	TD 3378'
3/26	Arb 3373 4" @ 3374 500 Acid Pump 39 oil & 8 Water Pot Grav. 40.9 TD 3378'

COMPLETED



