


Section 29 Township 17 Range 4E

Well No. #1 Deines

Company Slusser Drlg. Co.

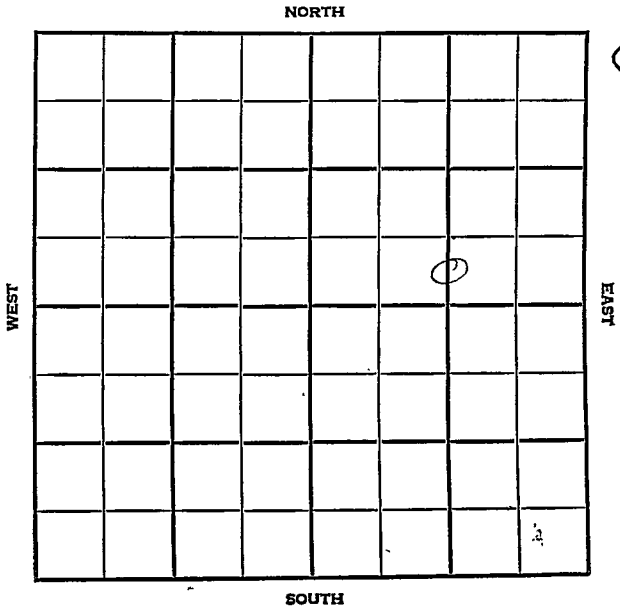

County Marion Elev. _____
 Sec. 29 Twp. 17 Rgs. 4E
 Company Slusser Drlg. Co.
 Farm Name Deines No. 1

TOPS	DEPTH	LOG	DATUM
Anh.			
TP.			
H.			
Tr.			
Dg.			
Bl.			
L.			
K.C.			
B.K.C.			
Ce.			
C.			
M.			
M.			
K.			
Mz.			
Me.			
V.			
S.			
S.			
A.			
R.			
PE.			
G.			
T.D.			

Loc. in Sec. C S/2 S/2 NE
 Geol. _____
 Contr. _____
 Co. Tools _____
 Pool _____
 Lost Springs _____

FIRST REPORT

OCT 31 '56

Date Command. 10-26-56
8" @ 133 w/65% Drlg. 2006

(Large handwritten scribble)

NOVA S 1020

(Small handwritten marks)

Co.
Lse.
No.
Sec.
T.
R.

County Marion Elev. 1470
 Sec. 29 Twp. 17 Rgs. 4E
 Company Slusser Drlg. Co.
 FarmName Deines No. 1

TOPS	DEPTH	LOG	DATUM	Loc. in Sec.
Anh.				C S/2 S/2 NE
Tr.				
H.				
Tr.				
Dg.				
BL.				
L.				Geol.
K.C.				Contr.
B.K.C.				Co. Tools
Ce.				Pool
C.				Lost Springs
M.	2386			
M.				
K.				
Mz.				
Me.				
V.				
S.				
S.				
A				
R.				
PE				
G.				
T.D.	2389			

NOV 23 '56
COMPLETE

Date Comm Spd. 10-26-56
8" @ 113 w/65 $\frac{1}{2}$ Drlg. 2006 NOV 7 '56
5 $\frac{1}{4}$ " @ 2388 wocT NOV 13 '56 ✓ NOV 21 '56
CO DD 2413 Frac P. 15
Bopd + Tr. wts.