


Section 26 Township 15 Range 14W

Well No. 4 Eichman "B"

Company Cities Service

Trapp

NORTH

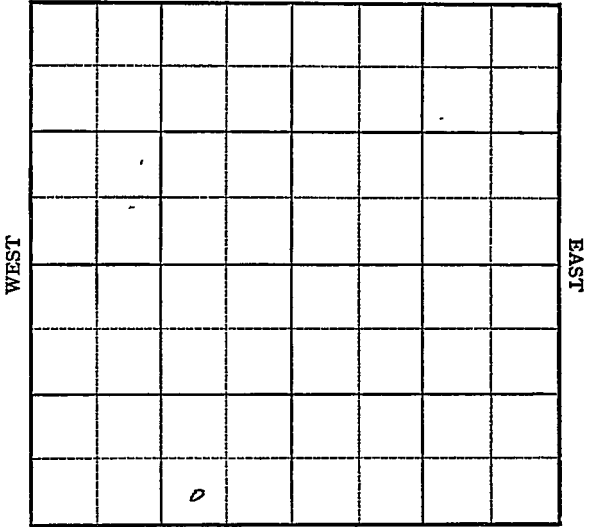

SOUTH

KANSAS

Russell

Sec. 26 Twp. 15 R. 14W

Well No. #4 Eichman "B" Farm

Cities Service

Company

Trapp Pool


_____ Ft. from N. Line

330' Ft. from S. Line

990' Ft. from E. Line

_____ Ft. from W. Line

SW SE SW

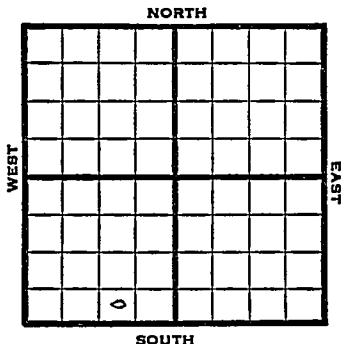

1949 Elev 1919' REPORT

3/23
3/30
4/6

8" @ 501'
Drlg 3167'
Lansing-3114'
Arb. 3360-64'
TD 3364'
5"@ 3361'
2700' oil 12 hrs.

4/13

TD 3364'
Arb. 3360'
5"@ 3361'
Pump 371 Oil / 7% W Pot
40⁹ Gr.
Comp

COMPLETED

KANSAS

Map No. _____ Sec. 26 Twp. 15 R. 14W

Well No. 4 Eichman "B"

Cities Service Company

FIRST REPORT Contractor

SW SE SW

SECTION PLAT

_____ Ft. from N. Line

330 _____ Ft. from S. Line

990 _____ Ft. from E. Line

_____ Ft. from W. Line

Russell County

Location _____

Rig up _____

Drilling and Remarks:

8" @ 501

RECORD

Cased _____ in., _____ ft.

Sand _____

Gas _____

Oil _____

Total Depth _____

PRODUCTION

1st 24 hrs. Nat. _____

1st 24 hrs. after shot _____

Gas _____ Cu. Ft.

Dry Hole _____

Abandoned _____

Date

MAR 23 1949 19

S. J. LEWIS Scout

