


SECTION 28 TOWNSHIP 17 RANGE 4E

WELL NO. #8 Novak

COMPANY Paul-Amos-Young

NORTH S/2 S/2 S/2 NW

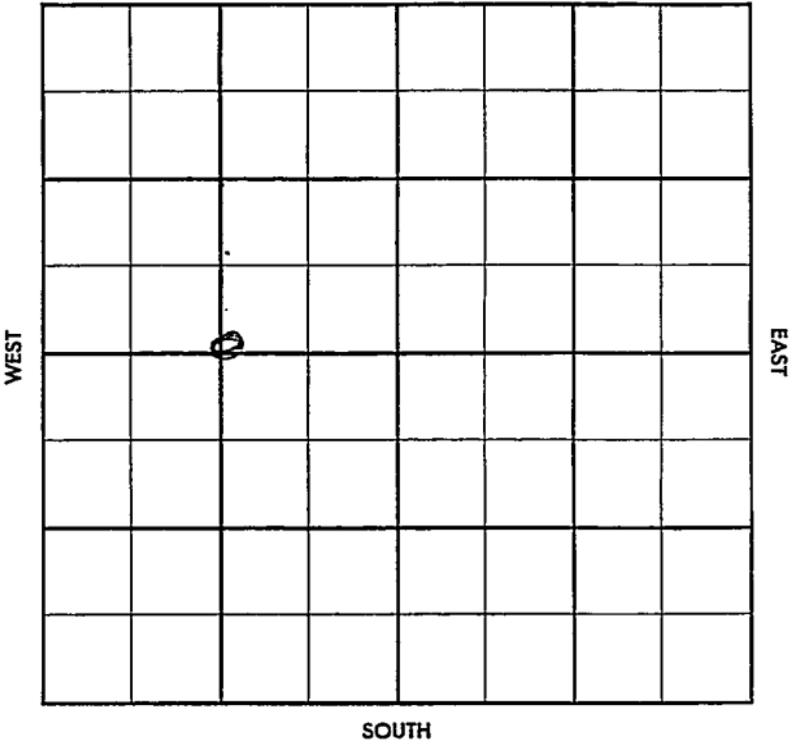

County Marion Elev. _____
 Sec. 28 Twp. 17 Rgs. 4E
 Company Paul-Amos-Young
 Farm Name Novak No. 8

TOPS	DEPTH	LOG	DATUM
------	-------	-----	-------

Anh.			
TP.			
H.			
Tr.			
Dg.			
Bl.			
L.			
K.C.			
B.K.C.			
Ce.			
C.			
M.			
M.			
K.			
Mz.			
Ma.			
V.			
S.			
S.			
A			
R.			
PE.			
G.			
T.D.			

Loc. in Sec. S/2 S/2 S/2 NW

Geol. _____
 Contr. Berentz Tool

Pool Lost Springs

FIRST REPORT	
•	AUG 14 '57


Date Comm. 8-10-57
8" @ 212/200, Drlg. 1379

[Large handwritten scribble]

Co.
Lsg
No.
Sec.
T.
R.

County Marion Elev. 1484 DF.
 Sec. 28 Twp. 17 Rge. 4E
 Company Paul-Amos-Young
 FarmName Novak No. 8

TOPS	DEPTH	LOG	DATUM	Loc. in Sec.
Anh.				S/2 S/2 S/2 NW
Tp.				
H.				
Tr.				
Dg.				
Bl.				
L.				Geol. _____
K.C.				Contr. _____
B.K.C.				
Ce.				Berentz Tool
C.	2415?			Pool
M.				Lost Springs
M.				
K.				
Mz.				
Mo.				
V.				
S.				
S.				
A.				
R.				
Pe.				
G.				
T.D.	2419			

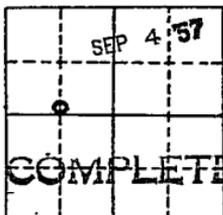

Date Comm. 8-10-57

8" @ 212/200. Drlg. 1379 5 1/2 2417

5 Mod 11-23-57 DD ? Frac Pop

SEP 4 '57 DD 2437 Frac Pop

P. 25 Bopd + 10 Bwpd