
Pratt KANSAS

SECTION 19 TOWNSHIP 27 RANGE ~~12xWx~~ 12 W

WELL NO. ~~#5~~ Seidel

COMPANY Schafer Drlg.

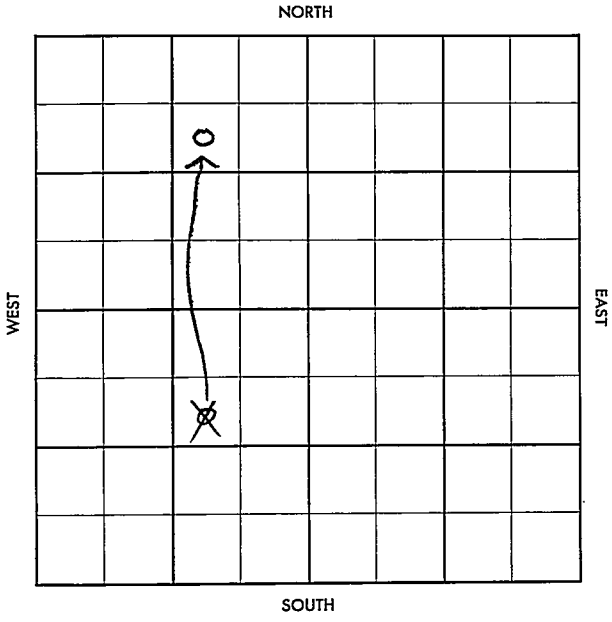

Pratt **KANSAS**

SEC.	TWP.	R.
19	27	12W

WELL NO.

#5 Seidel FARM

COMPANY

Schafer Drlg.

CONTRACTOR

Co. tools

Iuka-Carmi


_____ Ft. from N. Line

_____ Ft. from S. Line

_____ Ft. from E. Line

_____ Ft. from W. Line

SW NE ~~SW~~ NW

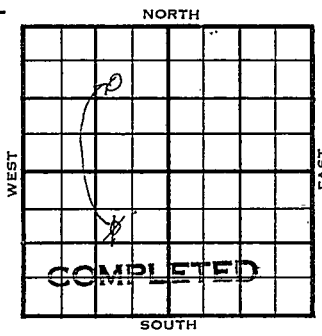

1956	ELEVATION REPORT
1-25	MIR

DX-78

FORM 513 REV. SUNRAY

County Pratt Elev.

Sec. 19 Twp. 27 Rge. 12W

Company Schafer Drlg.

Farm Name Seidel No. 5

TOPS	DEPTH	LOG	DATUM
Anh.			
T.P.			
H.			
Tr.			
Dg.			
B.L.			
L.			
K.C.			
B.K.C.			
Ce.			
C.			
M.			
M.			
K.			
Mz.			
Mg.			
V.			
S.			
S.			
A			
R.			
P€.			
G.			
T.D.			

Loc. in Sec. SW NE SW

Geol.

Contr. Co. tools

Pool Tulsa-Cannl

JAN 25 55

FIRST REPORT

Date Comm. M I R

Co. Lse. No. Sec. T. R.

CORRECTION

FORM 513 REV SUNRAY

County Pratt Elev. 1883

Sec. 19 Twp. 27 Rge. 12W

Company Schafer Drlg.

Farm Name Seidel No. 5

TOPS	DEPTH	LOG	DATUM
Anh.			
Tp.			
H.			
Tr.			
Dg.			
Bl.		3706	1823
L.		3714	1831
K.C.			
B.K.C.		4064	2181
Ce.			
C.		4123	2240
M.			
M.		4166	2283
K.			
Mz.			
Mo.		4220	2337
V.		4256	2373
S.		4295	2412
S. sd			
A			
R.			
P€.			
G.			
TD	4345		

Loc'n Sec. SW NE ~~SW~~ NW

Geol.

Contr. Co. tools

Pool Iuka-Carmi

COMPLETE

MAR 7 1956

Date Comm.

MIR FEB 1 '56 1-26-56 8 5/8 342

1250 lp 3040 FEB 8 '56 ID 4218

FEB 15 '56. 5½ 4344 cor 50/430-1

Flw 200 Bo ph Frac FEB 22 '56 v

Pkr @ 4250 pulled tbg & thru

csg 4.76 Bo ph 2an tbg

& S Flw 10 Bo ph. FEB 29 '56

MAR 7 - Ph Productivity tst

Flow 62.25 Bo no/w 8 hrs'

(over)

186 Bopd no wtr.
SP 3d PF 4305-18
RTD 4345
grav 39°

MAR 1 9 1956
R. G.