DX 78-1

Kingman

KANSAS

Section 18 Township 30 S Range 7 W

Well No. #2 Johnson

Company Amerada

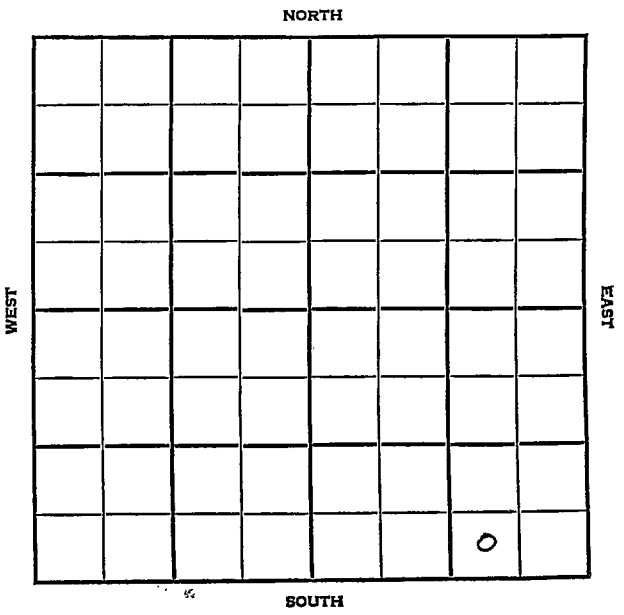

Kingman KANSAS

SEC.	TWP.	R.
18	30S	7W

WELL NO. #2 Johnson FARM

COMPANY Amerada

CONTRACTOR

Spivey

_____ Ft. from N. Line

_____ Ft. from S. Line

_____ Ft. from E. Line

_____ Ft. from W. Line

SW SE SE

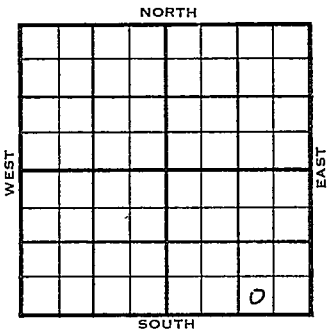

1955	ELEVATION 1530'	REPORT
9/28	Loc	
11/2	Comm 9-30-55 8 5/8" @ 206/200 H 3175 Dg 3206 L 3380 M 4169 K 4372 TD 4383 DST 4169-75 open 2 hr 62 mcfg rec 20' gcm 1400/20" DST 4177-94 open 2 hr 198 mcfg 2 hr Rec 185' gcm 1210# DST 4194-4220 open 1 hr rec 35' mud 115# DST 4224-75 open 1 hr rec 35' vso &gcm o# DST 4276-4307 open 2 hr rec 100' vsocm 150/298' 5 1/2" @ 4381 CO to 4338 44/4316-27 1000A S/4 go 1¼ gawph 4 hr frac SI F/~~8~~ 8.12 bf F/167 bo 77 bsw 24 hr Comp F/77 bopd 39 bw	

COMPLETED

DX-78

FORM 513 REV. SUNRAY

County Kinaman Elev.

Sec. 18 Twp. 30S Rge. 7W

Company Amerada

Farm Name Johnson No. 2

TOPS	DEPTH	LOG	DATUM
Anh.			
T.P.			
H.			
Tr.			
Dg.			
B.L.			
L.			
K.C.			
B.K.C.			
Ce.			
C.			
M.			
M.			
K.			
Mz.			
Mo.			
V.			
S.			
S.			
A			
R.			
P€.			
G.			
T.D.			

Loc. in Sec. SW SE SE

Geol.

Contr.

Pool. Spivey

FIRST REPORT

SEP 28 1955

Date Comm.

Loc.

Co. Lse. No. Sec. T. R.

FORM 513 REV. SUNRAY

County Kingman Elev. 1530

Sec. 18 Twp. 30 Rge. 7W

Company Amerada Pet.

Farm Name Johnson No. 2

TOPS	DEPTH	LOG	DATUM
Anh.			
T.P.			
H.	3175		1645
Tr.			
Dg.	3206		1676
Bi.			
L.	3380		1850
K.C.			
B.K.C.			
Ce.			
C.			
M.	4169		2639
M.			
K.	4372		2842
Mz.			
Mq.			
V.			
S.			
S.			
A			
R.			
P€.			
G.			
T.D.	4383		

Loc. in Sec. SW SE SE

Geol.

Contr.

Pool Spivey

COMPLETE

Date Comm. 9-30-55 NOV 2 1955

8 5/8" @ 206/200 DST 4169-75 open 2 hr
62 mcfg rec. 20' gcm 1400/20"
DST 4177-94 open 2 hr. 198 mcfg 2 hr.
Rec. 185' gcm 1210# DST 4194-4220
open 1 hr. rec. 35' mud 115#
DST 4224-75 open 2 hr. rec. 35' vso &
gcm 0# DST 4276-4307 open 2 hr.
rec. 100' vsocm 150/20" 5½" @ 4381

Co. Lse. No. Sec. T. R.

CO to 4338 44/ 4316-27 1000 A
S/ 4 go 1½ gawph 4 hr. frac ST
F/ 8.12 bf F/ 167 bo 77 bsw 24 hr.
Comp. F/-77 bopd 39 bw

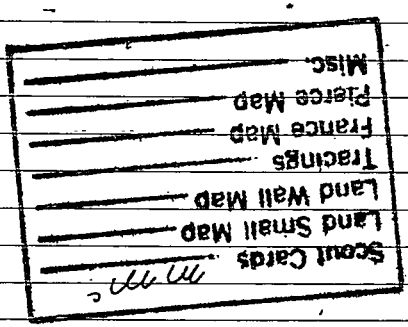

NOV 11 1955