


Section 29 Township 21 Range 14 W

Well No. #3 Lincoln "A"

Company Phillips Pet.

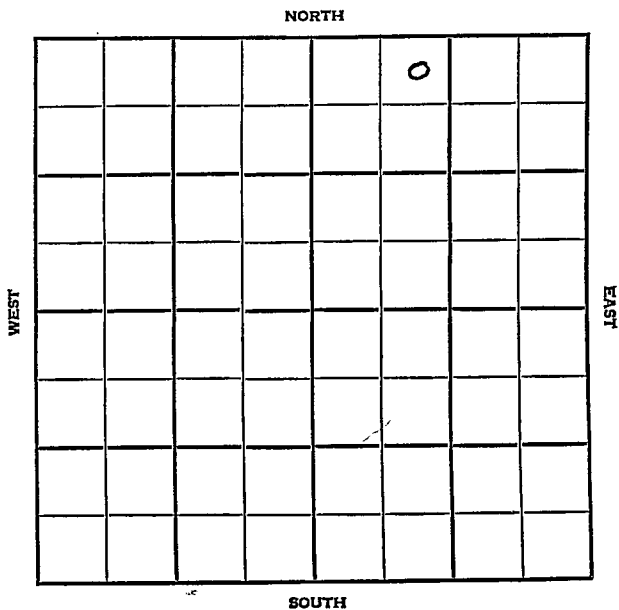

1956

4-5 P/ 25 bo, 40 bw, 10 hrs.

4-12 P/ 20 bo, 66 bw, 24 hrs.

4-19 No report

4-25 Comp. 38 bopd, 65% wtr.
TD 3800'

COMPLETED

County Stafford Elev. _____
 Sec. 29 Twp. (21) Rge. 1/W
 Company Phillips Pet.
 FarmName Lincoln "A" No. 3

TOPS	DEPTH	LOG	DATUM	Loc. in Sec.
Anh.				NE NW NE
Tr.				330' NL
Dg.				988' WL
Bl.				
L.				Geol. _____
K.C.				Contr. _____
B.K.C.				
Ce.				Co. tools
C.				
M.				Pool
M.				NW Lincoln Pool
K.				
Mz.				
Me.				
V.				
S.				
S.				
A.				
R.				
PE.				
G.				FIRST REPORT
T.D.				

offset	01
FEB 22 '56	
FIRST REPORT	

Date Comm. RUR

10

Co.
No.
Sec.
T.
R.

County Stafford Elev. 1942
 Sec. 29 Twp. 21 Rge. 14W
 Company Phillips Pet.
 Farm Name Lincoln "A" No. 3

TOPS	DEPTH	LOG	DATUM	Loc. in Sec.																					
Anh.				NE NW NE																					
Tp.				330' NL																					
H.	3296	3296		988' WL																					
Tr.	3320	3320																							
Dg.																									
Bl.	3411	3412	1470																						
L.	3422	3422	1480																						
K.C.				Geol.																					
B.K.C.	3651	3649	1706	Contr.																					
Ce. <i>Marm</i>	3673	3671	1729	Co. tools																					
C.																									
M.				Pool																					
M.				NW Lincoln																					
K.																									
Mz.																									
Me.																									
V.	3696	3704	1762	<table border="1"> <tr><td></td><td></td><td></td></tr> <tr><td></td><td></td><td></td></tr> <tr><td></td><td></td><td></td></tr> <tr><td></td><td></td><td></td></tr> <tr><td></td><td></td><td></td></tr> <tr><td></td><td></td><td></td></tr> <tr><td></td><td></td><td></td></tr> </table>																					
S. <i>5h</i>	3739	3744	1802																						
S. <i>sd</i>	3759	3760-70	1818																						
A	3795	3795	1853																						
R.																									
Pe.																									
G.																									
T.D.	3800			COMPLETE																					

Date Comm. 2-21-56 APR 25 1956

9 5/8" @ 636/420 7" @ 3796-75

20/ 3761-66 S/ 12.6 bo 77 bw 2 1/2 hr.

S/ 29 bo 95 bw 49 hr. frac

S/ 5 bo 30 bw 24 hr. S/ 17 bo

42 bw 24 hr. S/ 5 bo 16 bw 8 1/2 hr.

PB 3764 152/ 3705-43 S/ 17 bw 1 hr.

500 A S/ 147 bw 3 hr. 2500 A

S/ 187 bw 3 hr. S/ 43 bo 84 bw 34 hr.

S/ 8 bo 31 bw 5 hr. P/ 25 bo 40 bw
10 hr. P/ 20 bo 66 bw 24 hr.
Comp. 38 bopd 65% wtr.

R. G.

MAY 4 1956