

Russell


KANSAS

FORM 51 IOM 12-46 PETROL

Section 26 Township 15 Range 14W

Well No. 1 Eichman

Company B & R Drlg Co.

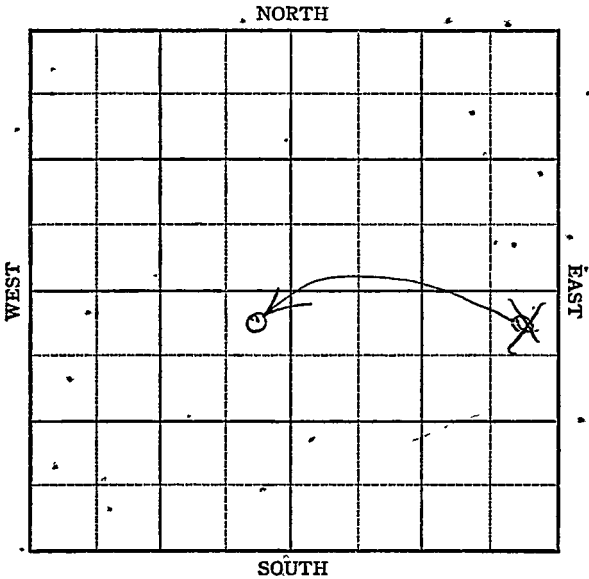

KANSAS

Russell county

Sec. 26 Twp. 15 R. 14W

Well No. 1 Eichman Farm

B & R. Drlg. et al Company

Trapp Pool


330 Ft. from N. Line

Ft. from S. Line

330 Ft. from E. Line

Ft. from W. Line

NE SE SW

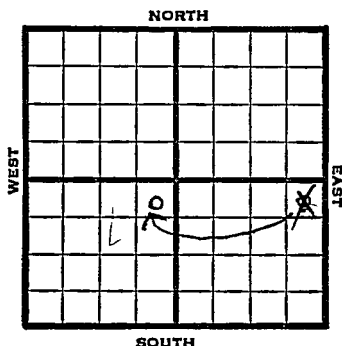

1947

Elev 1911'

REPORT

5/28

Location

6/3

Surface hole

6/10

8" @ 669
Drlg. 2645'

6/17

Lansing 3115'
Arbuckle 3395-3418 TD
5" @ 3190'
RUST

6/25

TD 3418'
Arbuckle 3395'
5" @ 3190'
Abandoned

ABANDONED

Map No. _____ Sec. 26 Twp. 15 R. 14^W

Well No. 1 Eichman

B & R Drlg. etal. Company

FIRST REPORT

Contractor

NE SE


SECTION PLAT

330 Ft. from N. Line

_____ Ft. from S. Line

330 Ft. from E. Line

_____ Ft. from W. Line

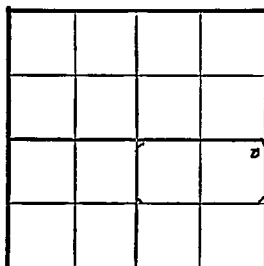

Russell County

Location X

Rig up _____

Drilling and Remarks:

RECORD

Cased _____ in., _____ ft.

Sand _____

Gas _____

Oil _____

Total Depth _____

PRODUCTION

1st 24 hrs. Nat. _____

1st 24 hrs. after shot _____

Gas _____ Cu. Ft.

Dry Hole _____

Abandoned _____

Date

MAY 28 1947 19 S. J. LEWIS Scout

Map No. 73 Sec. 26 Twp. 15 R. 14WWell No. 1 EichmanB & R Drlg. etal.


Company

CORRECTION

Contractor

NE SW

SECTION PLAT

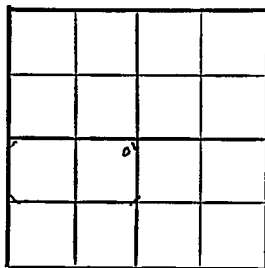330 Ft. from N. Line Ft. from S. Line330 Ft. from E. Line Ft. from W. LineRussell CountyLocation Rig up

Drilling and Remarks:

Reported
NE SE

RECORD

Cased in., ft.Sand Gas Oil Total Depth

PRODUCTION

1st 24 hrs. Nat. 1st 24 hrs. after shot Gas Cu. Ft.Dry Hole Abandoned

Date

JUN 11 1947

19

S. J. LEWIS

Scout

Map No. 73 Sec. 26 Twp. 15 R. 14W

Well No. 1 Eichman

B & R Drlg. etal. Company

ABANDONED

Contractor

NE SW

E. 1911
SECTION PLAT

	0		

330 Ft. from N. Line

 Ft. from S. Line

330 Ft. from E. Line

 Ft. from W. Line

Russell County

Location

Rig up

Drilling and Remarks:

Cur 83395
5" Q3/90

RECORD

Cased in., ft.

Sand

Gas

Oil

Total Depth 3418

PRODUCTION

1st 24 hrs. Nat.

1st 24 hrs. after shot

Gas Cu. Ft.

Dry Hole

Abandoned

Date

JUN 25 1947 19 S. J. LEWIS Scout