

Stafford

KANSAS

SECTION 29 TOWNSHIP 21 RANGE 11 W

WELL NO. #2 Lincoln "A"

COMPANY Phillips Pet.

NORTH

						0	

WEST

EAST

SOUTH

Stafford

KANSAS

SEC.	TWP.	R.
29	21	### 14W

WELL NO.

#2 Lincoln "A"

FARM

COMPANY

Phillips Pet.

CONTRACTOR

NW Lincoln

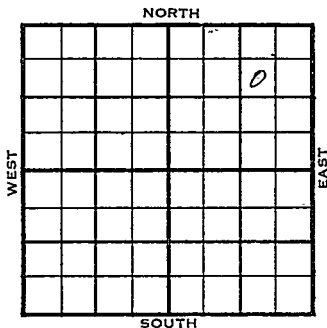
990 Ft. from N. Line

Ft. from S. Line

988 Ft. from E. Line

Ft. from W. Line

SW NE NE

SDX  $\frac{1}{4}$  mile

1956	ELEVATION 1945	REPORT
------	-------------------	--------

1-11 Location

1-19 Spud 1-14-56  
9" @ 615/420  
Drlg. 1937

1-26 Drlg. 3823

2-2 7" @ 3828/75

CO to 3810, 32/ 3760-68,

S/ 44 bo, 1 $\frac{1}{2}$  bw 2 hrs.S/ 89 bo, 2.76 bw 1  $\frac{3}{4}$  hrs.

S/ 209 bo, 8 bw 13 hrs.

T &amp; R

2-8 S/13.72 bo, .28 bw 1 hr., POP

2-16 P/ 240 bo, 19 bw 19 hrs.,

Waiting on ##### potential





FEB 15 '56

P. 240 Böt + 19 BW

17. 19 km wo Pot. FEB 22 '56 X

Ph P. 415 Börd no/uta

gran 34°

sp PF. 3760-68

RTD 3830

PBTD 3810

11

R. G.

MAR 1 1956