

Section 24 Township 26 Range 40W

Well No. 1 Kritzmire

Company W. J. Coppinger

NORTH

WEST

EAST

0

SOUTH

Sec. 24 Twp. 26 R. 40W

Well No. #1 Kritzmire Farm

W. J. Coppinger Company

Coppinger Contractor


330 Ft. from N. Line

Ft. from S. Line

Ft. from E. Line

330 Ft. from W. Line

NW NW SE

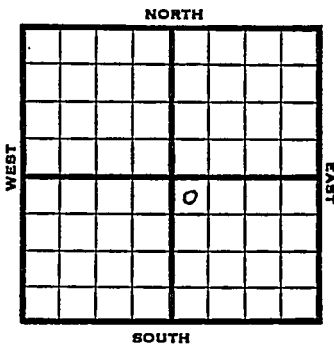

1953

Elev. 3354'

REPORT

Miss. Test

4/1 RUR

4/9 13" @ 800
Drlg. 1290'

4/16 Her 2442, Kr 2455, Win 2498, Up Ft. 2575, Low Ft. 2605

4/23 DST 2740-60 1 Hr. 10' M Drlg 3212'
Top 3630, Lans 3848
Drlg 4000'

4/30 N.R.

5/7 NR

5/21 "

5/28 NR

6/3 NR

OVER

#1 Kritzmire

1953

6/24

Spud 4-2-53

D&A

TD 5800

13" @ 800

Her 2442, Kri 2455, Win 2498, Ft.

Riley 2575

DST 2740-60, opn 1 hr., rec. 10' mud,

Top 3630, Lans 3848

DST 4286-4302, opn 1 hr., rec. 635'

sw, 1008#

DST 4527-50, opn 1 hr., rec. 435' sw,

Marm 5079

DST 5186-5203, opn 1 hr., rec. 10' mud,

425#

DST 5330-5405, opn 1 hr., rec. 170'

mud, 1320#

DST 5408-5510, opn $\frac{1}{2}$ hr., rec. 2585'

sw, 1470#

Miss 5500,

TD 5800

5" @ 2562

CO to 2531

50/2436-46, 96/2450-56, 48/2490-98,

7500A

251,000 gas, 70 gswph

PB 2446

231,000 gas, 11 gw 800A

91,000 gas, 11 gswph

D&A

ABANDONED


County Hamilton State Kansas

Sec. 24 (Blk. Twp.) 26 (Sur. Rge.) 40W Map No.

Operator W. J. Coppinger

Well No. 1 Farm Kritzmire

Elev. _____ Location NW NW SE

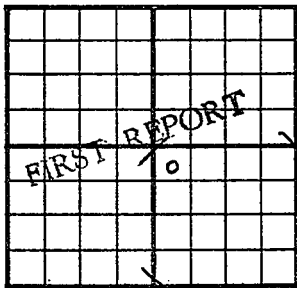

330 Ft. From N Line SE

330 Ft. From W Line Quarter

Ist. Report APR 1 1953

Completion _____


Remarks Miss. test

Coppinger - Contr.

Spudding Date _____

Drlg. Data _____

RUR

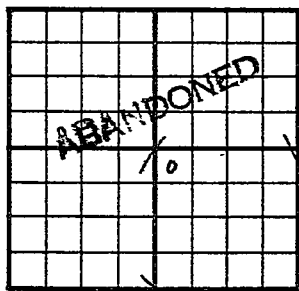County Hamilton State KansasSec. 24 (Blk. 26 (Sur. 40W (Twp. Rgs.) Map No.Operator W. J. CoppingerWell No. 1 Farm KritzmireElev. 3354 Location NW NW SE330 Ft. From N Line SE330 Ft. From W Line Quarter

1st. Report

Completion JUN 24 1953

Remarks

Coppinger - Contr.Spudding Date 4-2-53Drig. Data D & A TD 580013" @ 800 Her. 2442 Kri. 2455Win. 2498 Ft. Riley 2575 DST 2740-60open 1 hr. Rec. 10' mud Top. 3630Lans. 3848 DST 4286-4302 open 1 hr.Rec. 635' sw 1008# DST 4527-50open 1 hr. Rec. 435' sw Marm. 5079DST 5186-5203 open 1 hr. Rec. 10' mud425# DST 5330-5405 open 1 hr. Rec.170' mud 1320# DST 5408-5510open 1/2 hr. Rec. 2585' sw 1470#Miss. 5500 TD 5800 5" @ 2562CO. to 2531 50/ 2436-46 96/ 2450-5648/ 2490-98 7500 A 251,000 gas 70 gswPB 2446 231,000 gas 11 gw 800 A

Dirg. Data

91,000 gas

11 gswph
Misc.
D & A
Perce Map
France Map
Tracings
Land Wall Map
Land Small Map
Scout Cards

MA

JUN 30 1953