


Section 29 Township 13 Range 14W

Well No. #2, Miller

Company Tom Allen et al

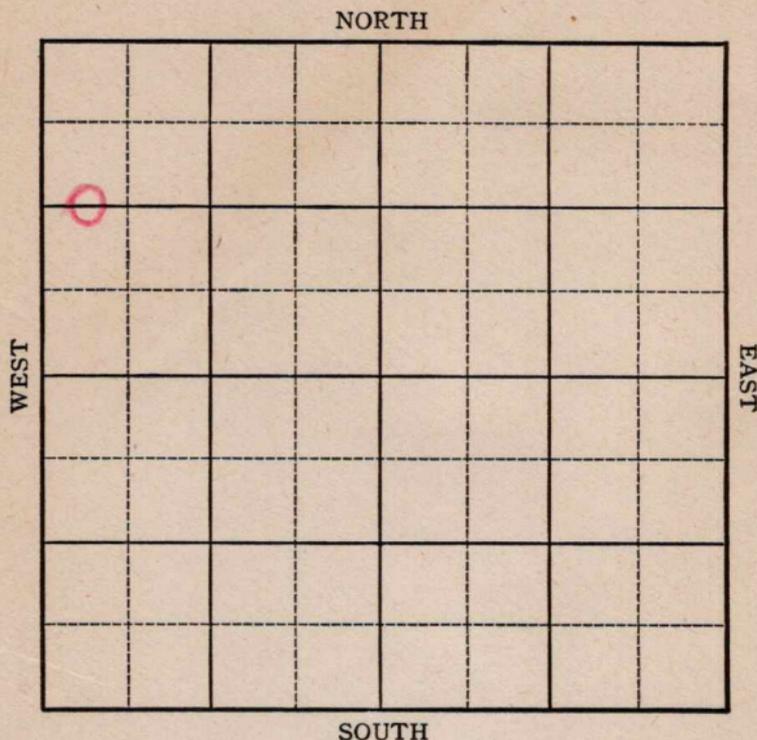

Sec. 29 **KANSAS** Twp. 13 R. 14W

Well No. #2 Miller Farm

Tom Allen et al Company

Russell


1320 Ft. from N. Line

_____ Ft. from S. Line

_____ Ft. from E. Line

330 Ft. from W. Line

CWL NW

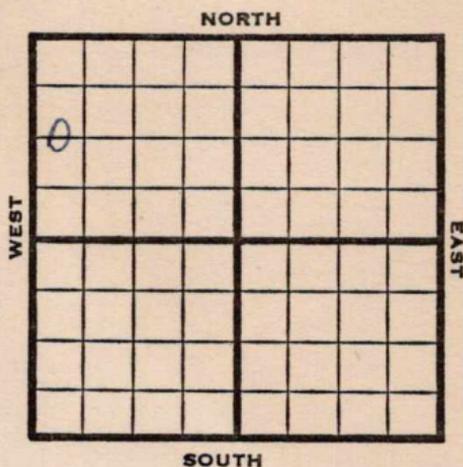

1946

Elev 1869' REPORT

5/15 Location

5/21 "

5/29 8" @ 115

Anhy. 908

Drlg. 2185'

6/5 " "

6/19 **Arb 3303**

5" @ 3304

Pump 75 Pot

33.0 Gr

TD 3317'

COMPLETED

KANSAS

Kansas Pool Name Russell

Map No. 72 Sec. 29 Twp. 13 R. 14W

Well No. 2 Miller

Tom Allen etal Company

FIRST REPORT

Contractor

C W L N W

SECTION PLAT

1320 Ft. from N. Line

_____ Ft. from S. Line

_____ Ft. from E. Line

330 Ft. from W. Line

Russell County

Location

Rig up _____

Drilling and Remarks:

RECORD

Cased _____ in., _____ ft.

Sand _____

Gas _____

Oil _____

Total Depth _____

PRODUCTION

1st 24 hrs. Nat. _____

1st 24 hrs. after shot _____

Gas _____ Cu. Ft.

Dry Hole _____

Abandoned _____

Date

MAY 15 1946 19

S. J. LEWIS Scout

Kansas Pool Name Russell Pool

KANSAS

Map No. 72 Sec. 29 Twp. 13 R. 14W

Well No. 2 Miller

Tom Allan etal

Company

COMPLETED

Contractor

C W L NW

E 11869

SECTION PLAT

1320 Ft. from N. Line

⊙			

_____ Ft. from S. Line

330 Ft. from E. Line

_____ Ft. from W. Line

Russell County

Location _____

RECORD

Cased _____ in., _____ ft.

Rig up _____

Sand _____

Drilling and Remarks:

Gas _____

Core 3303

Oil _____

5" C 3304

Total Depth 3317

Pump 75 B.D.

PRODUCTION

1st 24 hrs. Nat. _____

1st 24 hrs. after shot _____

Gas _____ Cu. Ft.

Dry Hole _____

Abandoned _____

33rd 2nd

Date

JUN 19 1946

19

S. J. LEWIS

Scout