

KANSAS

Form 51—5M—7-39—Palace

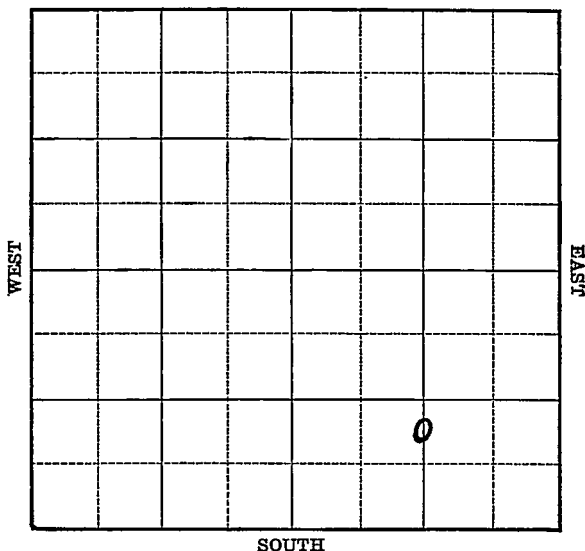
Russell

Section 26 Township 15 Range 14-W

Well No. #4 Hennessy

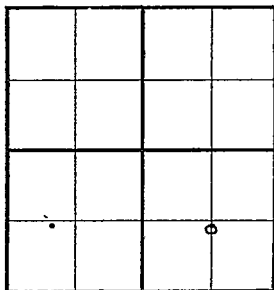
Company Cities Service Oil

NORTH Trapp Arb.Pool



Map No. 73 Sec. 26 Twp. 15 R. 14WWell No. 4 HennessyCities Service Oil Company

Contractor

FIRST REPORTC N L S $\frac{1}{2}$ SE**SECTION PLAT** Ft. from N. Line990 Ft. from S. Line1320 Ft. from E. Line Ft. from W. Line

TRAPP ARB. POOL

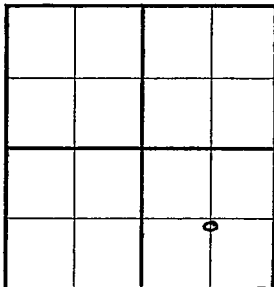
Location Rig up Drilling and Remarks:
Derrick**RECORD**Cased in., ft.Sand Gas Oil Total Depth **PRODUCTION**1st 24 hrs. Nat. 1st 24 hrs. after shot Gas Cu. Ft.,Dry Hole Abandoned

Date

FEB 28 1940 19 S. J. LEWIS Scout

Map No. 73 Sec. 26 Twp. 15 R. 14WWell No. 4 HennessyCities Service Oil CompanyCOMPLETE ContractorC N L S $\frac{1}{2}$ SE

SECTION PLAT

 Ft. from N. Line990 Ft. from S. Line1320 Ft. from E. Line Ft. from W. Line

TRAPP ARB. POOL

Location Rig up

Drilling and Remarks:

*Cor & 3354**5" @ 3355**3000 Acid**Pump. 595 + 2 1/10 % W**P. X.*

RECORD

Cased in., ft.Sand Gas Oil Total Depth 3364

PRODUCTION

1st 24 hrs. Nat. 1st 24 hrs. after shot Gas Cu. Ft.Dry Hole Abandoned

Date

3

APR 3 1946 19

S. J. LEWIS Scout