


DX 78-1 Harper

KANSAS

Section 26 Township 31 Range 9W

Well No. #1 Jacobs

Company Purcell & Mull

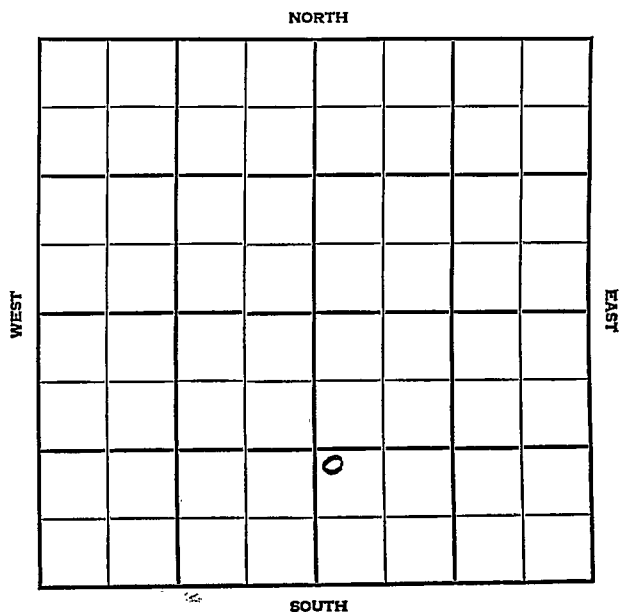

KANSAS

SEC.	26	TWP.	31	R.	9 W
WELL NO.					
# 1 Jacobs					FARM
COMPANY					
Purcell & Mull					
CONTRACTOR					

Co. tools

Grabs


Ft. from N. Line

Ft. from S. Line

Ft. from E. Line

Ft. from W. Line

NW SW SE

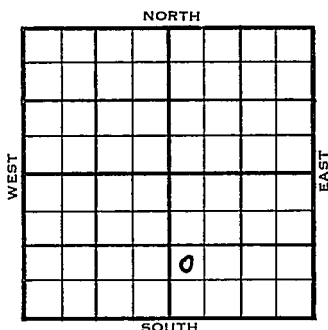

1955	ELEVATION 1605'	REPORT
6/8	Comm. 6-6-55 8" @ 189/150 WOC	
9-14	DST 4401-09 op 2 hrs. rec. 35' mud, specks of oil, BHP 743# 20"; DST 4409-19 op 2 hrs. rec. 40' hocm plus 155' muddy oil, 30' wtr., BHP 910# 20"; 5 1/2" 4419; 48/4407 1/2-16; 500 A; frac; swb 3 1/2 boph no wtr. 6 hrs.; pmp 48 bo plus 20% wtr. 24 hrs. pmp 5 bo / 20% wtr. 24 hrs.; frac; 2000 A; lost load; 250 A; frac; swb 5 1/2 boph no wtr. no time; pmp 30 to 40 bopd plus gas; pmp 110 bopd plus 15% wtr. Tops: M. 4399 T.D. 4419'	
		COMPLETED

DX-78

County Harper Elev. _____
 Sec. 26 Twp. 31 Rge. 9W
 Company Purcell & Mull
 Farm Name Jacobs No. 1

TOPS	DEPTH	LOG	DATUM
Anh.			
Tr.			
H.			
Tr.			
Dg.			
BL.			
L.			
K.C.			
B.K.C.			
Ce.			
C.			
M.			
M.			
K.			
Mz.			
Mq.			
V.			
S.			
S.			
A			
R.			
Pe.			
G.			
T.D.			

Loc. in Sec. _____

NW SW SE

Geol. _____

Contr. _____

Co. tools

Pool _____

Grabs

FIRST REPORT
 JUN 8 '55
 0

Date Comm. 6-6-55

8" @ 189/150 WOG

K-27

County HarberElev. 1605Sec. 26 Twp. 31SRge. 9WCompany Purcell & MullFarmName JacobsNo. 1

TOPS	DEPTH	LOG	DATUM	Loc. in Sec.
Anh.				NW SW SE
Tp.				
H.				
Tr.				
Dg.				
Bl.				
L.				Geol.
K.C.				Contr.
B.K.C.				Co. tools
Ce.				Pool
C.				Grabs
M.	4399		2794	
M.				
K.				
Mz.				
Ma.				
V.				
S.				
S.				
A				
R.				
Pe.				
G.				
TD	4419			

Date Comm. 6-6-55

SEP 14 1955

8" 189 w/150; DST 4401-09 op 2 hrs. rec. 35'

mud, specks of oil, BHP 743# 20"; DST

4409-19 op 2 hrs. rec. 40' hocm plus 155'

muddy oil, 30' wtr., BHP 910# 20"; 5 1/2" 4419;

48/4407 1/2-16; 500 A; frac; swb 3 1/2 boph no

wtr. 6 hrs.; pmp 48 bo plus 20% wtr. 24 hrs.

pmp 5 bo / 20% wtr. 24 hrs.; frac; 2000 A;

lost load; 250 A ; frac; swb 5 1/2 boph no wtr.

no time; pmp 30 to 40 bopd plus gas;

OVER

pmp 110 bopd plus 15% wtr.

Scout Cards	
Land Small Map	
Land Wall Map	
Tracings	
France Map	
Pierce Map	
Misc.	

SEP 26 1955