


DX 78-1

Kiowa KANSAS

Section 13 Township 28 Range 19W
Well No. 1 Johansen
Company Aladdin Petr.

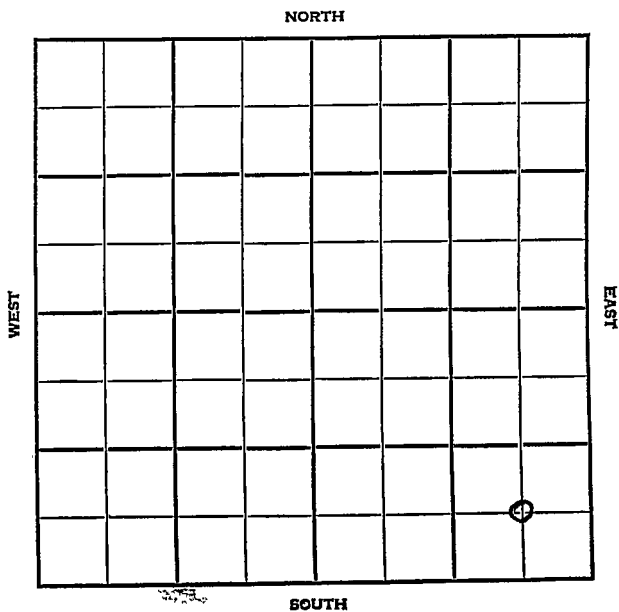

SEC.	TWP.	R.
13	28	19W

WELL NO.

1 Johansen

FARM

COMPANY

Aladdin Pet.

CONTRACTOR

Lewis Drlg.


Wildcat

_____ Ft. from N. Line

660 _____ Ft. from S. Line


660 _____ Ft. from E. Line

_____ Ft. from W. Line

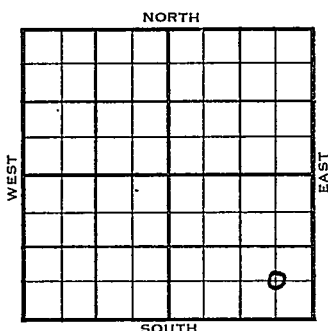

C SE SE

	ELEVATION	REPORT
1954	2256	2258'
8/11	M I R	
9/22	Spud 8-14-54 SI Gas Well TD 5510' 8" @ 498' Br. Lime 4241', "ans 4263' DST 4280'-4305' opn 1 hr, closed 20 min GTS in 38 min, rec 95' gcm 100' ho & gc 60' gassy oil, 1300# DST 4390'-4420' opn 1 hr, rec 340' sw 1563# DST 4738'-90' opn 1/2 hr, rec 5' Mud, 15# Miss 4855', Miss Chat 4863' DST 4862'-4900' opn 1-3/4 hr, gas in 15 min, rec 150' gcm 1290# Viola 5124' Simp 5256', Arb 5333' TD 5510' 5" @ 4950' DST 5384'-85' opn 1 hr, rec 3850' sw, 1770# Schlumberger Tops: Br. Lime 4244', KC 4256', Miss 4864' Kh. 5148', Viola 5173' Simp 5256' Arb 5333' 120/ 4860-80 168/ 4860-90 frac. SSG 50,000 cfg. fr ac, 2000 A 1,000,000 cfgpd. Comp shut in gas well.	

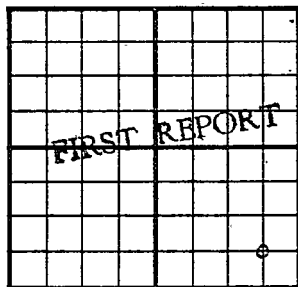County Kiowa State KansasSec. 13 (Blk.) 28 (Sur.) 19W Map No. (Twp.)Operator Aladdin Pet.Well No. 1 Farm JohansenElev. 2256 Location C SE SE660 Ft. From S Line SE660 Ft. From R Line Quarter1st. Report AUG-11 1954

Completion


Remarks

Lewis Drlg. - Contr.

Spudding Date

Drlg. Data WildcatM I R

County Kiowa State Kansas
 Sec. 13 (Blk.) 28 (Sur.) 19W Map No.
 Operator Aladdin Pet.
 Well No. 1 Farm Johansen
 Elev. 2256 2258 Location C SE SE

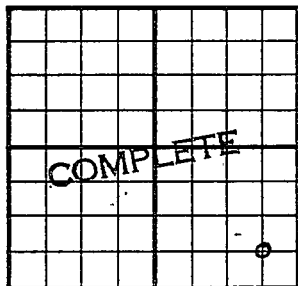

660 Ft. From S Line SE
660 Ft. From E Line Quarter
 1st. Report Aug 11 1954
 Completion SEP 22 1954
 Remarks
Lewis Drlg. - Contr.
 Spudding Date 8-14-54

Drlg. Data SI gas well TD 5510 Wildcat
8" @ 498 Br. lime 4241 Lans. 4263
DST 4280-4305 open 1 hr. closed 20 min.
gas to surface in 38 min. Rec. 95' gcm
100' ho & gcm 60' gassy oil. 1300#
DST 4390-4420 open 1 hr. Rec. 340' sw
1563# DST 4738-90 open 1/2 hr. Rec.
5' mud 15# Miss. 4855 Miss. chat 4863
DST 4862-4900 open 1 3/4 hr. Gas in 15. m.
Rec. 150' gcm 1290# Viola 5124
Simp. 5256 Arb. 5333. TD 5510
5" @ 4950 DST 5384-85 open 1 hr.
Rec. 3850' sw 1770# SCHLUMBERGER TOPS--
Br. lime 4244 KC 4256 Miss. 4864
Kh. 5148 Viola 5173 Simp. 5256

FABEN GILSTRAP

Delg. Data.....
 Arb. 5333.....
 frac 8SG.....
 1,000,000.....
 Scout Cards

1207/4860-80

168/4860-90

50,000 efg

frac 2000 A

shut in gas well

1954 OCT 7