


Section 36 Township 31 Range 9 W

Well No. #3 Campbell

Company Purcell & Mull

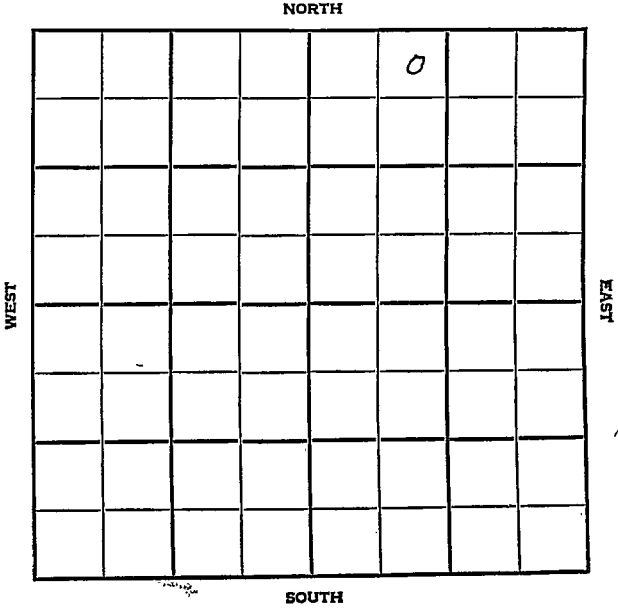

SEC. 36	TWP. 31	R. 9W
------------	------------	----------

WELL NO. #3 Campbell FARM

COMPANY Purcell & Mull

CONTRACTOR Co. Tools

Grabs


\_\_\_\_\_ Ft. from N. Line

\_\_\_\_\_ Ft. from S. Line

\_\_\_\_\_ Ft. from E. Line

\_\_\_\_\_ Ft. from W. Line

NE NW NE

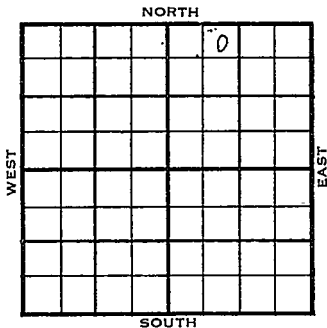

1956	ELEVATION	REPORT
------	-----------	--------

2-1 Comm. 1-27-56  
8" @ 160/125  
Drlg. 2340

County Harper Elev. \_\_\_\_\_  
 Sec. 36 Twp. 31 Rge. 9W  
 Company Purcell & Mull  
 Farm Name Campbell No. 3

TOPS	DEPTH	LOG	DATUM	Loc. in Sec.
Anh.				NE NW NE
Tp.				
H.				
Tr.				
Dg.				
BL.				
L.				
K.C.				Geol. _____
B.K.C.				Contr. _____
Ce.				Co. tools
C.				
M.				Pool
K.				Grabs
Mz.				
Mo.				
V.				
S.				
S.				
A.				
R.				FIRST REPORT
PE.				
G.				
T.D.				

Date Comm. 1-27-56  
8" @ 160/125 dirg. 2340

*(Large handwritten mark, possibly '27')*

Co.  
 Loc.  
 No.  
 Sec.  
 T.  
 R.

h

County Harper Elev. 1547  
 Sec. 36 Twp. 31 Rgn. 9W  
 Company Parcell & Mull  
 Farm Name Campbell No. 3

TOPS	DEPTH	LOG	DATUM	Loc. in Sec.
Ark				NE NW NE
Tr				
H.				
Tr.				
D.				
Bl.				
L.				Geol.
K.C.				Contr.
BXC.				Co. tools
Ce.				Pool
C.				Grabs
M.	4366		2819	
M.				
K.				
Ne				
V.				
S.				
A				
R				
PE				
G.				
TD	4381			

Date Comm. 1-27-56 FEB 29 1956  
 8" @ 160/125 drlg. 2350 FEB 8 '56

Ø 4358 FEB 15 '56 DST 4368-74  
1 hr rec. 75' SGCM BHP 287  
120" DST 4374-81 up 2 hrs  
9 in 6" rec. 2370' oil + 85' MC  
+ 51' MCW BHP 1565/20"  
5 1/2 @ 4380/150 co 4380 20/  
4373-78 \$ 5 Boph Frac  
Flwd 45 Boph 8 hrs w/o Pat

FEB 22 '56



FEB 29 '53

BH Bomb FI

1787 Bapd no 100

R. G.

MAR 8 1956