KANSAS


Russell

FORM 51 5M 2-38 TPCO.

Section 29 Township 13 Range 14-W

Well No. 2 Miller

Company Lauck & Moncrief

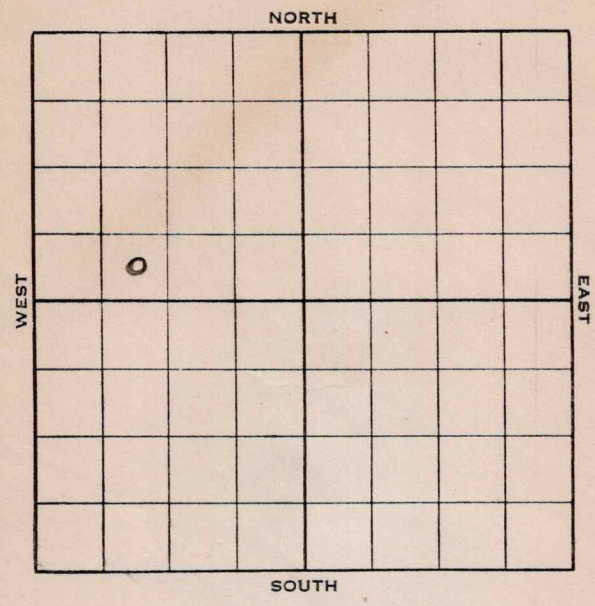


Form 252-A—5M—9-37 KANSAS Russell

Sec. 29 Twp. 13 R. 14-W

Well No. #2 Miller Farm

Lauch & Moncrief Company

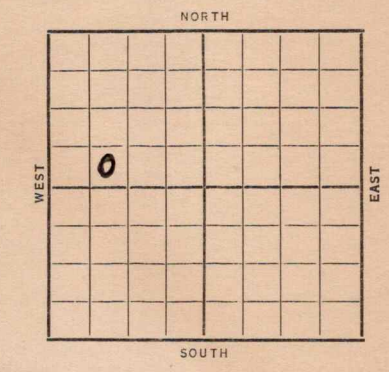

_____ Ft. from N. Line

330 Ft. from S. Line

_____ Ft. from E. Line

990 Ft. from W. Line

Elev. 1854

Date	REPORT
1938	
7/13	Dig Cellar
7/22	12" - 64'. WOC.
7/29	Anhy 896'. Dlg. 2289'.
8/5	Topeka 2688'.
	Shows oil 2757-62'.
	" " 2885-90'.
	" " 2930-40'.
	Lans. 3021'. Sat. 3060-65'.
	Arb. 3282'. T.D. 3284'.
	Sat. core. 7" - 3282'. RUST.
8/12	Dlg. cement.
8/17	7" at 3283'.
	Arb. 3282'.
	T. D. 3303'.
	500 acid.
	Potential 657 bbls.
	COMPLETED

Form 26—1M Bks.—2-29

Russell KANSAS

Map No. 72 Sec. 29 Twp. 13 R. 14W

Well No. 2 Miller

Lauck & Moncrief
Company

Contractor

FIRST REPORT

SE SW NW


_____ Ft. from N. Line

330 Ft. from S. Line

_____ Ft. from E. Line

990 Ft. from W. Line

SECTION PLAT

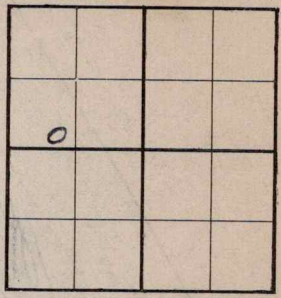

Location _____

Rig up _____

Drilling and Remarks:
Dig Cellar

RECORD

Cased _____ in., _____ ft.

Sand _____

Gas _____

Oil _____

Total Depth _____

PRODUCTION

1st 24 hrs. Nat. _____

1st 24 hrs. after shot _____

Gas _____ Cu. Ft.

Dry Hole _____

Abandoned _____

Date

JUL 13 1938 19_____

H. D. Hatfield Scout

Form 26—1M Bks.—2-29

Russell KANSAS

Map No. 72 Sec. 29 Twp. 13 R. 14W

Well No. 2 Miller

Lauck & Moncrief Company

Contractor

COMPLETED

SE SW NW


Ft. from N. Line

330 Ft. from S. Line

Ft. from E. Line

990 Ft. from W. Line

SECTION PLAT

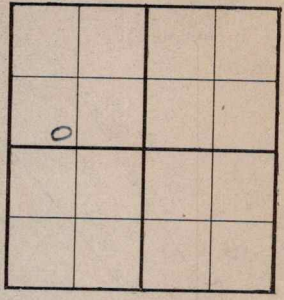

Location

Rig up

Drilling and Remarks:

500 Acid

POT 657

RECORD

Cased 7 in., 3283 ft.

~~Sand~~ Arb 3282

Gas

Oil

Total Depth 3303

PRODUCTION

1st 24 hrs. Nat.

1st 24 hrs. after shot

Gas Cu. Ft.

Dry Hole

Abandoned

Date

AUG 17 1938

19

H. D. Hatfield Scout