


Pratt KANSAS

DX 78-1

Section 36 Township 28 Range 11W

Well No. 1 Tena (*Tena*)

Company Phillips Pet.

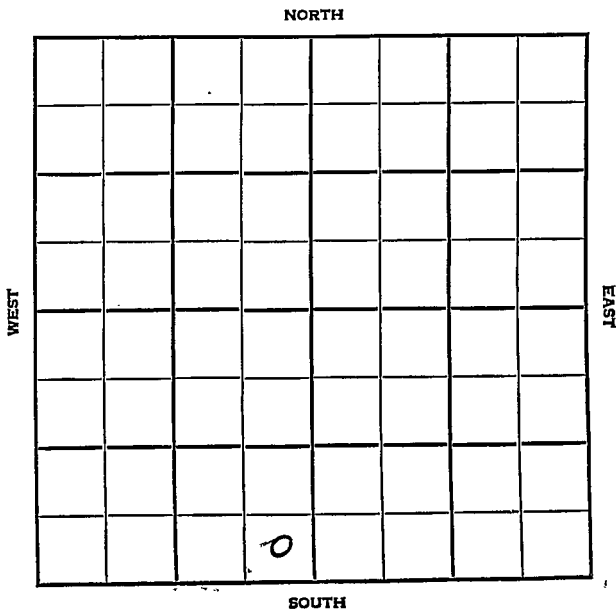

Pratt

KANSAS

SEC.	TWP.	R.
36	28	14 W

WELL NO. # 1 Tena FARM

COMPANY Phillips Pet.

CONTRACTOR Phillips
Earl Pool


_____ Ft. from N. Line

330 _____ Ft. from S. Line

330 _____ Ft. from E. Line

_____ Ft. from W. Line

SE SE SW

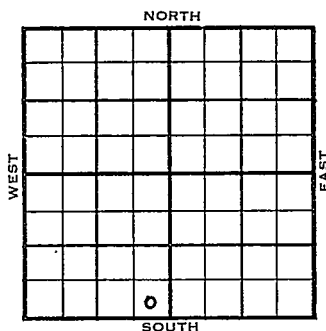

	ELEVATION	REPORT
1954	1986'	

6/23

Location

2/29

Spud 7-24-54 10" @ 363
 TD 4655' Top. 3433 Heeb 3781
 Tor. 3800 Doug. 3819 Br. lime 3960
 Lans. 3079 B KC 4339 Viola 4480
 Simp. sh. 4510 Simp sd 4516'
 Arb. 4620'
 TD 4655 Schl tops: Heeb 3781',
 Tor. 3800 Br. lime 3959 Lans 3979
 B K6 4340 Viola 4480 Simp sh 4512
 Simp sd 4518 Arb. 4631
 TD 4557' 7" @ 4650 16/4569-73
 B/14 GW 8 hr. 500 A B/21 BO 22 BW
 15 hrs. B/8 BO 6 BW ~~4~~ 5 hrs.
 SP 4558 20/4543-48 B/21 BO 8 BW
 12 hr. 48/4526-38 S/13 $\frac{1}{2}$ BO 5 BW
 6 hrs. Petro-frac S/12 BO
 S/192 BO 101 BW
 P/137 BO 30 BW
 Comp. 210 BO 52 BWPD

COMPLETED

Orig. Data

P/ 137 bo 30 bw Comp. 210 bo 52 bwpd

_____	Misc.
_____	Merge Map
_____	France Map
_____	Tracings
_____	Land Wall Map
_____	Land Small Map
_____	Scout Cards

2

OCT 13 1954