

Kiowa


KANSAS

SECTION 16 TOWNSHIP 28 RANGE 16 W

WELL NO. #1 Kinney

COMPANY Eldorado Ref.

NORTH

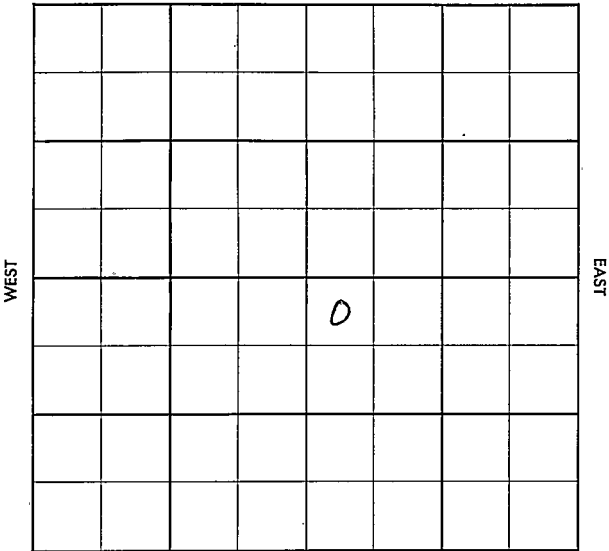

SOUTH

# HOT FILE Kiowa

KANSAS

|      |      |      |
|------|------|------|
| SEC. | TWP. | R.   |
| 16   | 28 S | 16 W |

WELL NO.

#1 Kinney


FARM

COMPANY

Eldorado Refining Co.

CONTRACTOR

Ben Brack  
Wildcat

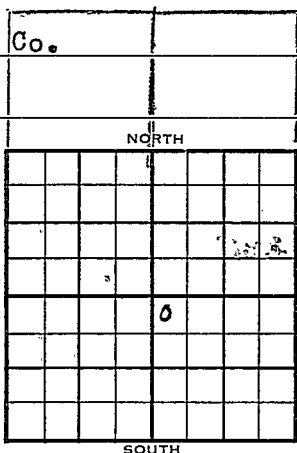

\_\_\_\_\_ Ft. from N. Line

\_\_\_\_\_ Ft. from S. Line

\_\_\_\_\_ Ft. from E. Line

\_\_\_\_\_ Ft. from W. Line

NW NW SE

SDX DHC \$2,000.00

Lse. (S-25748)

|      |           |            |
|------|-----------|------------|
|      | ELEVATION | REPORT     |
| 1955 | 2160'     | (WH5-DC95) |

12/5 Viola test well @ 4790'  
To be commenced by Dec. 20, 1955  
To be completed by Feb. 1, 1956  
(See DHC Ltr. 12-2-55)

11/30 Location (F. R. Tkt)

12-8 Spud 12-5-55  
8 5/8" @ 365/250  
WOC

12-15 Drlg. 3645

12-22 Heeb. 4022  
Tor. 4038  
Doug. 4052  
Br. lime 4180  
Lans. 4196  
BKC 4516  
Drlg. 4710'

12-29 Miss. Chat 4726  
Kh. 4762  
Viola 4816  
TD 4828,  
DST 4693-4718, op 40 min. gas in 2 min.  
ga, 3,300 mcfg in 15 min. 3,700 mcfg in  
30 min., rec. 10' mud, 1575/20"  
DST 4723-38, op 1/2 hr. gas in 1 min.,  
5 mil. cfg in 15 min., 1575/20"  
DST 4736-58, op 1/2 hr. rec. 5' mud,  
40/15", 5 1/2" @ 4769, MICT

DX-78

OVER

1956

1-6 40/ 4729-39, 1,630 mcfg after 5 hr.,  
ga. 2,845 mcfg, to frac

1-12 Frac, 6,160 mcfg,  
SI  
Waiting on separator

1/18 Comm. 12-5-55  
8-5/8" @ 365/250  
DST 4693-4718, open 40 min, gas in  
2 min, 3,300 MCFG in 15 min,  
3,700 MCFG in 30 min, rec 10' mud.  
1575/20"  
DST 4723-38 open  $\frac{1}{2}$  hr, gas in 1 min,  
5 MCFG in 15 min, 1575/20"  
DST 4736-58, open  $\frac{1}{2}$  hr rec 5' mud.  
40/15". 5 $\frac{1}{2}$ " @ 4800  
40/4729-39 1,630 MCFG after 5 hr.  
1260/15" 1,700 MCFG after 12 hr.  
500 A. 2,845 MCFG, frac.  
6,160. MCFG.  
Comp. SI gas well. 5,684 MCFGPD.  
Sample Tops: H. 4022', Tr. 4038',  
Dg. 4052', BL 4180', L. 4196',  
BKC 4516', M/Chat 4726', K. 4762',  
V. 4816'.  
Log: H. 4028', Tr/ 4045', Dg. 4068'  
BL 4184', L. 4200', BKC 4515',  
M. Chat 4726', K. 4762', V. 4824'  
TD 4828'.

COMPLETED - Contract Sec. advised *ms.*

County Kimberly Elev. \_\_\_\_\_  
 Sec. 16 Twp. 28 Rge. 16W  
 Company Eldorado Ref.  
 Farm Name Kimney No. 1

| TOPS                | DEPTH | LOG | DATUM       | Loc. in Sec.  |            |  |  |                     |  |  |  |  |  |  |  |  |  |  |  |
|---------------------|-------|-----|-------------|---|------------|--|--|---------------------|--|--|--|--|--|--|--|--|--|--|--|
| Anh.                |       |     |             | NW NW SE  |            |  |  |                     |  |  |  |  |  |  |  |  |  |  |  |
| Tr.                 |       |     |             |   |            |  |  |                     |  |  |  |  |  |  |  |  |  |  |  |
| H.                  |       |     |             |   |            |  |  |                     |  |  |  |  |  |  |  |  |  |  |  |
| Tr.                 |       |     |             |   |            |  |  |                     |  |  |  |  |  |  |  |  |  |  |  |
| Dg.                 |       |     |             |   |            |  |  |                     |  |  |  |  |  |  |  |  |  |  |  |
| Bl.                 |       |     |             |   |            |  |  |                     |  |  |  |  |  |  |  |  |  |  |  |
| L.                  |       |     |             |   |            |  |  |                     |  |  |  |  |  |  |  |  |  |  |  |
| K.C.                |       |     |             | Geol. _____   |            |  |  |                     |  |  |  |  |  |  |  |  |  |  |  |
| B.K.C.              |       |     |             | Contr. _____  |            |  |  |                     |  |  |  |  |  |  |  |  |  |  |  |
| Ce.                 |       |     |             | <b>Ben Brack</b>  |            |  |  |                     |  |  |  |  |  |  |  |  |  |  |  |
| C.                  |       |     |             |   |            |  |  |                     |  |  |  |  |  |  |  |  |  |  |  |
| M.                  |       |     |             | Pool _____  |            |  |  |                     |  |  |  |  |  |  |  |  |  |  |  |
| M.                  |       |     |             | <b>Wildcat</b>  |            |  |  |                     |  |  |  |  |  |  |  |  |  |  |  |
| K.                  |       |     |             |   |            |  |  |                     |  |  |  |  |  |  |  |  |  |  |  |
| Mz.                 |       |     |             |   |            |  |  |                     |  |  |  |  |  |  |  |  |  |  |  |
| Ma.                 |       |     |             |   |            |  |  |                     |  |  |  |  |  |  |  |  |  |  |  |
| V.                  |       |     |             |   |            |  |  |                     |  |  |  |  |  |  |  |  |  |  |  |
| S.                  |       |     | <b>SIX-</b> | <table border="1"> <tr> <td><b>OKM</b></td> <td></td> <td></td> </tr> <tr> <td><b>FIRST REPORT</b></td> <td></td> <td></td> </tr> <tr> <td></td> <td></td> <td></td> </tr> <tr> <td></td> <td></td> <td></td> </tr> <tr> <td></td> <td></td> <td></td> </tr> </table> | <b>OKM</b> |  |  | <b>FIRST REPORT</b> |  |  |  |  |  |  |  |  |  |  |  |
| <b>OKM</b>          |       |     |             |   |            |  |  |                     |  |  |  |  |  |  |  |  |  |  |  |
| <b>FIRST REPORT</b> |       |     |             |   |            |  |  |                     |  |  |  |  |  |  |  |  |  |  |  |
|                     |       |     |             |   |            |  |  |                     |  |  |  |  |  |  |  |  |  |  |  |
|                     |       |     |             |   |            |  |  |                     |  |  |  |  |  |  |  |  |  |  |  |
|                     |       |     |             |   |            |  |  |                     |  |  |  |  |  |  |  |  |  |  |  |
| S.                  |       |     |             |   |            |  |  |                     |  |  |  |  |  |  |  |  |  |  |  |
| A.                  |       |     |             |   |            |  |  |                     |  |  |  |  |  |  |  |  |  |  |  |
| R.                  |       |     |             |   |            |  |  |                     |  |  |  |  |  |  |  |  |  |  |  |
| Pe.                 |       |     |             |   |            |  |  |                     |  |  |  |  |  |  |  |  |  |  |  |
| G.                  |       |     |             |   |            |  |  |                     |  |  |  |  |  |  |  |  |  |  |  |
| T.D.                |       |     |             |   |            |  |  |                     |  |  |  |  |  |  |  |  |  |  |  |

Date Comm. \_\_\_\_\_  
 Location \_\_\_\_\_

\_\_\_\_\_

**25-25**

Co.  
Lse.  
No.  
Sec.  
T.  
R.

|           |                       |       |             |
|-----------|-----------------------|-------|-------------|
| County    | <b>Xiowa</b>          | Elev. | <b>2160</b> |
| Sec.      | <b>16</b>             | Twp.  | <b>28</b>   |
| Company   | <b>El Dorado Ref.</b> |       |             |
| Farm Name | <b>Kinney</b>         | No.   | <b>1</b>    |

| TOPS   | DEPTH       | LOG         | DATUM       | Loc. in Sec.     |
|--------|-------------|-------------|-------------|------------------|
| Anh.   |             |             |             | NW NW SE         |
| Tr.    |             |             |             |                  |
| H.     | <b>4022</b> | <b>4028</b> |             |                  |
| Tr.    | <b>4038</b> | <b>4045</b> |             |                  |
| Dg.    | <b>4052</b> | <b>4068</b> |             |                  |
| Bl.    | <b>4180</b> | <b>4184</b> |             |                  |
| L.     | <b>4196</b> | <b>4200</b> | <b>2040</b> |                  |
| K.C.   |             |             |             | Geol.            |
| B.K.C. | <b>4516</b> | <b>4515</b> | <b>2355</b> | Contr.           |
| Ce.    |             |             |             |                  |
| C.     |             |             |             | <b>Ben Brack</b> |
| M.     | <b>Chat</b> | <b>4726</b> | <b>4726</b> | <b>2566</b>      |
| M.     |             |             |             | Pool             |
| K.     | <b>4762</b> | <b>4762</b> | <b>2602</b> | <b>Wildcat</b>   |
| Mz.    |             |             |             |                  |
| Ma.    |             |             |             |                  |
| V.     | <b>4816</b> | <b>4824</b> | <b>2664</b> |                  |
| S.     |             |             |             |                  |
| S.     |             |             |             |                  |
| A.     |             |             |             |                  |
| R.     |             |             |             |                  |
| PE.    |             |             |             |                  |
| G.     |             |             |             |                  |
| T.D.   | <b>4828</b> |             |             |                  |

Date Comm. **12-5-55** JAN 1 8 1956**8 5/8" @ 365/250 DST 4693-4718**

open 40 min. gas in 2 min. 3,300 mcfg

in 15 min. 3,700 mcfg in 30 min.

rec. 10' mud 1575/20" DST 4723-38

open 1/2 hr. gas in 1 min. 5 mcfg

in 15 min. 1575/20" DST 4736-58

open 1/2 hr. rec. 5' mud 40/15"

5 1/2" @ 4800 40/ 4729-39 1,630 mcfg

after 5 hr.: 1260/15" 1,700 mcfg

OVER

after 12 hr. 500 A 2,845 mcfg frac  
6,160 mcfg Comp. SI-gas well 5,684 mcfgpd

M. M.

APR 27 1966