

Q.W.W.O.
DX 78-1

Pratt KANSAS

Section 36 Township 28 Range 14W


Well No. 1 Earl Moore

Company Lario & Sinclair ^{oil & Gas}

NORTH

WEST

EAST

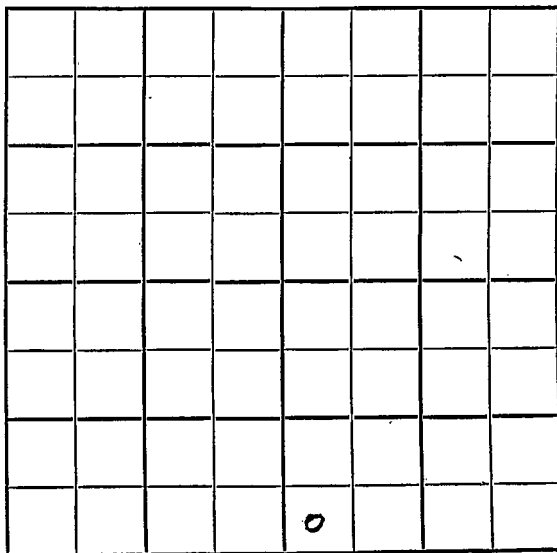

SOUTH

O.W.W.O

Pratt

KANSAS

SEC.	TWP.	R.
36	28	14 W ✓

WELL NO.

1 Earl Moore

FARM

COMPANY

Lario & ~~Sinclair~~ ^{Oil & Gas}

CONTRACTOR

Sterling Drlg.

~~Wildcat~~ EARL

Ft. from N. Line

330


Ft. from S. Line

Ft. from E. Line

330

Ft. from W. Line

SW SW SE

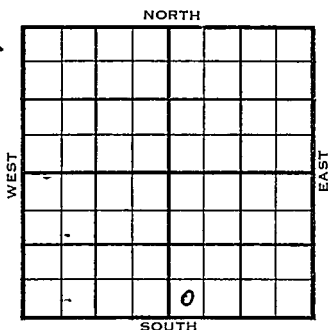

Phillips - acreage

	ELEVATION	REPORT
1954	1982'	
4/27	Location	
5/12	8" @ 359' w/300 sks Drlg 2627'	
5/19	Top 3172', Heeb 3774', B. Oread 3812' Doug 3850' Br. L. 3952', Lans 3964' DST 3852'-3972' 1 hr, 1280' SW 1455# Drlg 3975'	
5/26	DST 4217-45', 1 hr., 67,000 gas, 1590' oil, 1410# DST 4354-65', 40", 5' M, 30# DST 4300-30', 1 hr., 5' M, 30# DST 4442-75', 1 hr., 30' M, 30# V 4480'	
6/2	DST 4482-4500', 1 hr., 90' GCM, 1345# Simp 4515' DST 4513-37', 1½ hrs., 10' m, 30' O&GCM 410' clean oil, 1438# DST 4536-52', 1 hr., 20' M, 94# DST 4549-65', 1 hr., 35' M, 198# Arb. 4604', RTD 4661' 5" @ 4658', Schl 4512/18 - 4520-34 S/5½ B04 hrs., 1000A	

1 Earl Moore

1954

6/9

6/23

NR

Spudding 5-6-54

Oil well

TD 4661

8" @ 359

Top 3172 Heeb 3774 B. Oread 3812

Doug 3850 Br. lime 3953 Lans. 3964

DST 3852-3972 open 1 hr. Rec. 1280' sw
1455#

DST 4217-45

open 1 hr. Rec. 67,000 gas 1590' oil
1410#

DST 4254-65 open 40 min. Rec. 5' mud
30#

DST 4300-30 open 1 hr. Rec. 5' mud
30#

DST 4447-75 open 1 hr. Rec. 308 mud
30#

Viola 4480

DST 4482-4500 open 1 hr. Rec. 90' gcm
1345#

Simp. 4515

DST 4513-37 open 1½ hr. Rec. 10' mud
30' o & gcm 410 clean oil 1438#

DST 4536-52 open 1 hr. Rec. 20' mud
94#

DST 4549-65 open 1 hr. Rec. 35' mud
198#

ARB. 4604

TD 4661

5" @ 4658 perf/ 4512-18 4520-34

S/ 5½ bo 4 hr. 500 A 500 M-A S/5½ boph
4 hr. 500 A 500

frac F/ 40 boph 4 hr. F/ 20 boph 4 hr.

perf/ 4223-27 S/ 2 goph 250 A

F/ 160 bo 2500 A F/ 43 bo 3 hr

F/ 17 boph 1 hr. F/ 11 boph 1 hr

Comp. 1258 bopd

COMPLETED

O.W.W.O.

1955

9/14

OTD 4661' 5" @ 4668' PB 4300'

Comp. 207 BOPD 20% wtr.

Tops: L. 3963', Marm 4300', Miss 4388'

K. 4410', V. 4454, Sd 4520', A 4621'

FIRST REPORT & COMPLETED

County Pratt State Kansas

Sec. 36 (Blk.) 28 (Sur.) 14W Map No.

Operator **Lario & Sinclair**

Well No. 1 Farm Earl Moore

Elev.	Location	SW	SE	SE
-------	----------	----	----	----

10

FIRST REPORT

330 Ft. From S Line SE

330. Ft. From W Line Quarter

1st. Report APR 27 1954

Completion

Remarks Phillips - acreage.

Sterling Drlg. - Contr.


Spudding Date

Drig. Data Wildcat

Location

J. G. McGEHEE

County Pratt State Kansas
 Sec. 36 (Blk. 28) (Sur. 14W) Map No. 14W
 Operator Lario & Sinclair
 Well No. 1 Farm Earl Moore
 Elev. 1982 Location SW SW SE

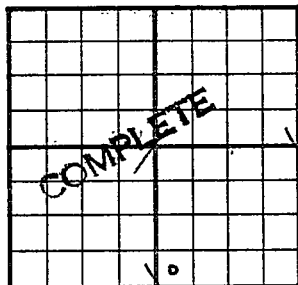

330 Ft. From S Line SE
330 Ft. From W Line Quarter

1st. Report

Completion JUN 23 1954

Remarks Wildcat

Sterling Drlg. - Contr.

Spudding Date 5-6-54

Drlg. Data Oil well TD 4661

8" @ 359 Top. 3172 Heeb. 3774

B. Oread 3812 Doug. 3850 Br. lime 3953

Lans. 3964 DST 3852-3972 open 1 hr.

Rec. 1280' sw 1455# DST 4217-45

open 1 hr. Rec. 67,000 gas 1590' oil

1410# DST 4254-65 open 40 min. Rec.

5' mud 30# DST 4300-30 open 1 hr.

Rec. 5' mud 30# DST 4447-75 open 1 hr

Rec. 30' mud 30# Viola 4480

DST 4482-4500. open 1 hr. Rec. 90' gcm

1345# Simp. 4515 DST 4513-37 open

1 1/2 hr. Rec. 10' mud 30' o & gcm


410' clean oil 1438# DST 4536-52

open 1 hr. Rec. 20' mud 94#

J. G. McGEHEE

Drlg. Data

DST 4549-65 open 1 hr. Rec. 35' mud
198# Arb. 4604 TD 4661 5" @ 4658
perf. 4512-18 4520-34 S/ $5\frac{1}{2}$ bo 4 hr.
500 A 500 M-A S/ 1 boph frac
F/ 40 boph 4 hr. F/ 20 boph 4 hr.
perf/ 4223-27 S/ 2 goph 250 A
F/ 160 bo 2500 A F/ 43 bo 3 hr.
F/ 17 boph 1 hr. F/ 11 boph 1 hr.
Comp. 1258 bopd

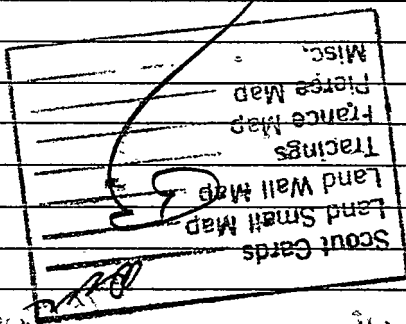

JUL 1 1954

O.W.W.O.

FORM 513 REV. SUNRAY

OWWO

County Pratt Elev. 1982
 Sec. 36 Twp. 28 Rge. 14W
 Company Lario Oil & Gas
 Farm Name Earl Moore No. 1

Co.

Lse.

No.

Sec.

T.

R.

TOPS DEPTH LOG DATUM

Loc. in Sec.

Anh.				SW SW SE
Tr.				
H.				
Tr.				
Dg.				
Bl.				
L.	3963			Geol.
K.C.				Contr.
B.K.C.				
Ce.				
C.				
M.	4200			Pool
M.	4388			Earl
K.	4410			
Mz.				
Me.				
V.	4454			
S.				
S.	4520			
A.	4621			
R.				
Pe.				
G.				
T.D.				

FIRST REPORT
 SEP 14 '55
 COMPLETE

0

Date Comm.

OTD 1/4/61 5" @ 4658 PB 4300

Comp. 207 bopd 20% wtr.

Handwritten signature/initials

W.W.O.

OWWO

Duplicate

Loc. **Pratt** Elev. **1982**
 Sec. **36** Twp. **28S** Rge. **14W**
 Company **Earl Oil & Gas**
 Farm Name **Earl Moore** No. **1**

TOPS	DEPTH	LOG	DATUM	Loc. in Sec.
Anh.				SW SW SE
Tr.				
Dg.				
Bl.				
L.	3963		1981	Geol.
K.C.				Contr.
B.K.C.				
Ce.				
C.				
M. arm	4300		2318	Pool
Miss	4388		2406	Earl
K.	4410		2428	
Mz.				
Mq.				
V.	4454		2472	
S. Sd	4520		2538	
S.				
A	4621		2639	
R.				
Pe.				
G.				
T.D.				

FIRST REPORT
COMPLETE

Date Comm. **OTD 4461; 5" 4658; FBL3009** EP 2 1 1955

Comp. 208 bopd 20% wtr.