


Section 29 Township 13 Range 14 W

Well No. # 4 Miller "A"

Company R. E. Driscoll

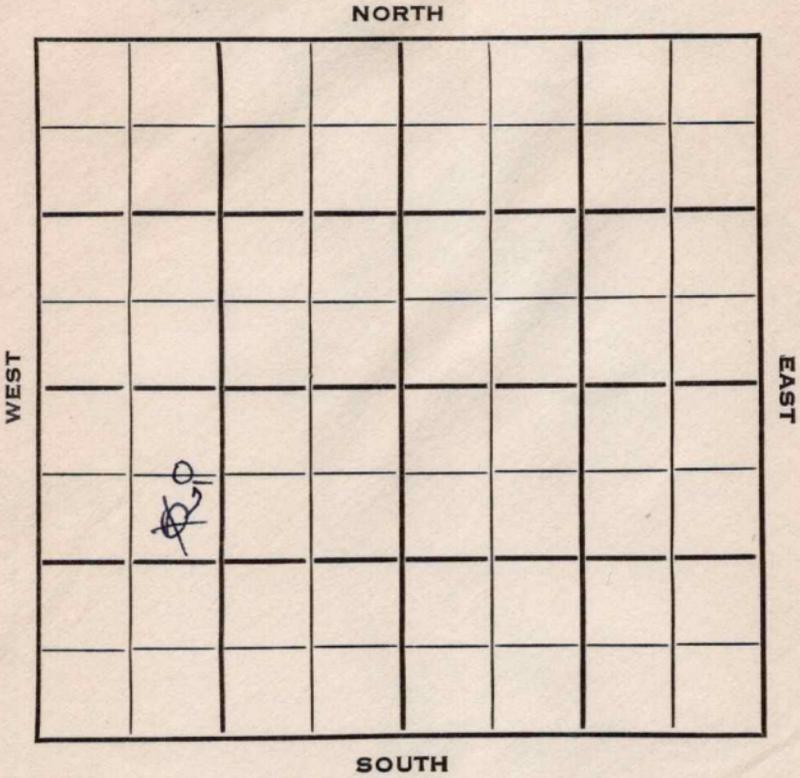

Russell

KANSAS


SEC.	TWP.	R.
29	13	14 W ✓

WELL NO. # 4 Miller "A" FARM

COMPANY R. E. Driscoll

CONTRACTOR Mast Drlg.
Atherton Pool

990 660 Ft. from N. Line
 _____ Ft. from S. Line
 _____ Ft. from E. Line
 990 Ft. from W. Line

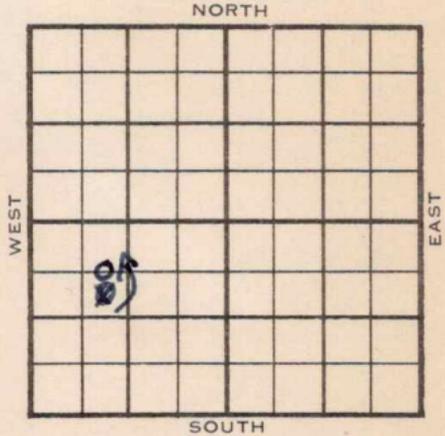

CEL
~~SE~~ NW SW

	ELEVATION	REPORT
1953	1869'	

12/2 Spud 11-28-53
 8" @ 190
 Drlg. 642'

12/9 KC 3033
 Drlg. 3083'

12/16 Arb. 3311'
 RTD 3314'
 5" @ 3312'

1954
 1/27 Spud 11-28-53 Oil well TD 3315
 8" @ 190 KC 3033 Arb. 3311
 TD 3314 5" @ 3312 DD 3315 100 A
 S/26 BO 2 BWPD
 Comp. 20 BOPD 4 BW

COMPLETED

County Russell State Kansas

Sec. 29 (Blk.) 13 (Sur.) 14W Map No.

Operator R. E. Driscoll

Well No. 4 Farm Miller "A"

Elev. 1869 Location C E L NW SW

660 Ft. From N Line SW

990 Ft. From W Line Quarter

1st. Report

Completion JAN 27 1954

Remarks Atherton Pool

Mast Drlg. - Contr.

Spudding Date 11-28-53

Drlg. Data Oil well TD 3315

8" @ 190 KC 3033 Arb. 3311 TD 3314

5" @ 3312 DD 3315 100 A S/ 26 bo

2 bwpd Comp. 20 bopd 4 bw

~~KAROL~~

Map No. _____ Sec. 29 Twp. 13 R. 14W

Well No. 4 Miller "A"

R. E. Driscoll Company

CORRECTION Contractor

C E L N W S W


SECTION PLAT

660 Ft. from N. Line

_____ Ft. from S. Line

_____ Ft. from E. Line

990 Ft. from W. Line

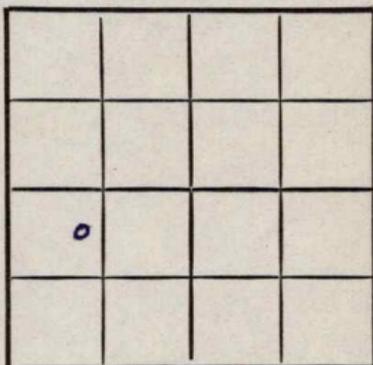

Russell County

Location _____

Rig up _____

Drilling and Remarks:

Reported
SE NW SW

RECORD

Cased _____ in., _____ ft.

Sand _____

Gas _____

Oil _____

Total Depth _____

PRODUCTION

1st 24 hrs. Nat. _____

1st 24 hrs. after shot _____

Gas _____ Cu. Ft.

Dry Hole _____

Abandoned _____

Date

DEC 2 1953 19

J. G. MCGEHEE Scout