


Section 13 Township 14 Range 15W

Well No. #1 Nedenthal "C"

Company Chet Loving

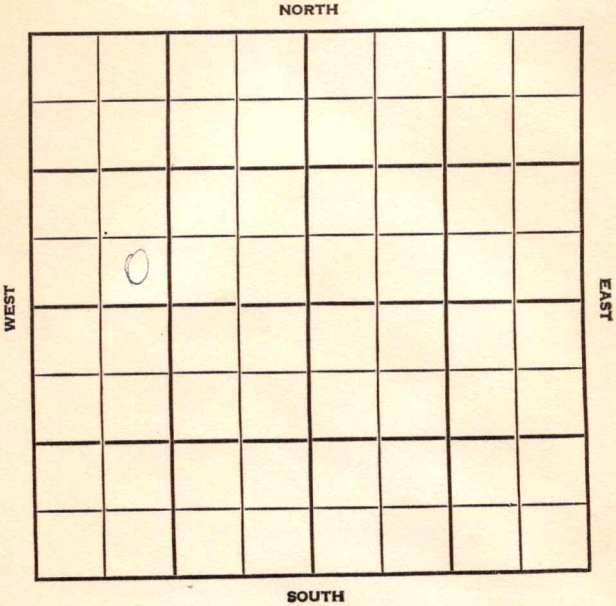

County Russell Elev. 1847 Co.
 Sec. 13 Twp. 14 Rge. 15W
 Company Chet Loving
 Farm Name Nedenthal "C" No. 1

TOPS	DEPTH	LOG	DATUM	Loc. in Sec.
Anh.	880			SE SW NW
Tp.	2704			
H.	2955			
Tr.	2974			
Dg.				
Bl.				
L.	3009			Geol.
K.C.				Contr.
B.K.C.				Sierra
Ce.				Pool
C.				Gorham
M.				
M.				
K.				
Mz.				
Mo.				
V.				
S.				
S.				
A.	3259			
R.				
Pe.				
G.				
TD.	3260			

NOV 29 '56
 COMPLETE

Date Comm. 11-11-56

8" @ 891/ drlg. 916 NOV 21 '56 5 1/2 e
 3259/ NOV 28 '56 DD 3261 TD FU
 650' oil now 4 hrs POP
 P. 25 BOPD

County Russell Elev. _____
 Sec. 13 Twp. 14 Rge. 15W
 Company Chet Loving
 Farm Name Nedenthal "C" No. 1

TOPS	DEPTH	LOG	DATUM	Loc. in Sec.
Anh.	880			SE SW NW
Tp.				
H.				
Tr.				
Dg.				
BL.				
L.				Geol. _____
K.C.				Contr. _____
B.K.C.				Sierra
Ce.				Pool _____
C.				Gorham
M.				
M.				
K.				
Mz.				
Me.				
V.				
S.				
S.				
A.				
R.				
PE.				
G.				
T.D.				

Geol. _____

Contr. _____

Sierra

Pool _____

Gorham

NOV 14 1956

FIRST REPORT

Date Comm. 11-11-56
8" @ 891/ d rlg. 916

NOV 5 0 1956

113