


Section 7 Township 19 Range 12W

Well No. #1 Hmmeke

Company Alpine Oil & Royalty et al

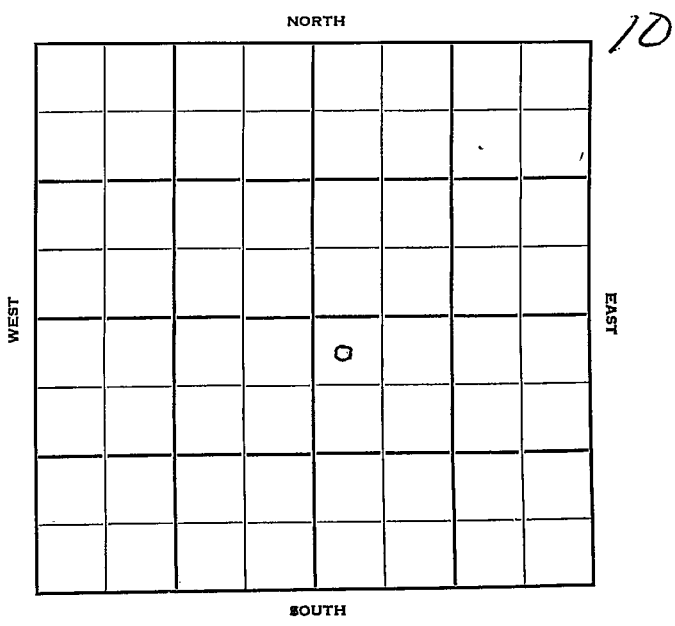

KANSAS

Barton

Sec. 7 Twp. 19 R. 12-W ☒

Well No. #1 Hammeke Farm

Alpine Oil & Royalty et al Company

Contractor

Wildcat


330 Ft. from N. Line

Ft. from S. Line

Ft. from E. Line

330 Ft. from W. Line

NW NW SE

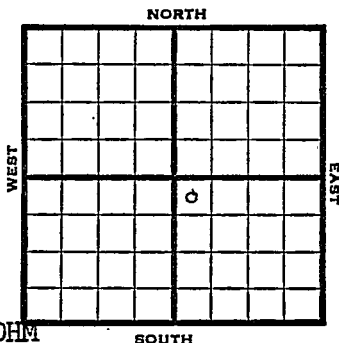

Derby $\frac{1}{4}$ ins. Sunray DHM

1950 Elev 1868

REPORT

6/7 Rig Up

6/21 TD 3496

8" @ 240

Anhy 730

Br lime 3179

Cong 3434

DST 3446-55 opn 30 min rec 8' mud

D&A

Heeb 3068

Lans 3192

Arb 3446

ABANDONED

Kansas


Map No. _____ Sec. 7 Twp. 19 R. 12WWell No. 1 HammekeAlpine Oil & Royalty et al Company_____
ContractorN¹° N¹° SE

SECTION PLAT

330 Ft. from N. Line

_____ Ft. from S. Line

_____ Ft. from E. Line

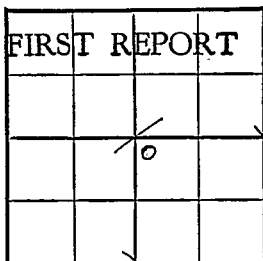330 Ft. from W. LineBarton Derby $\frac{1}{2}$ ins. Sunray DHM

Location _____

Rig up X

Drilling and Remarks:

RECORD

Cased _____ in., _____ ft.

Sand _____

Gas _____

Oil _____

Total Depth _____

PRODUCTION

1st 24 hrs. Nat. _____

1st 24 hrs. after shot _____

Gas _____ Cu. Ft.

Dry Hole _____

Abandoned _____

Date

JUN 7 195019J. E. TYRA


Scout

Kansas

Map No. _____ Sec. 7 Twp. 19 R. 12WWell No. 1 HammekeAlpine Oil & Royalty etal. Company

Contractor

NW NW SE

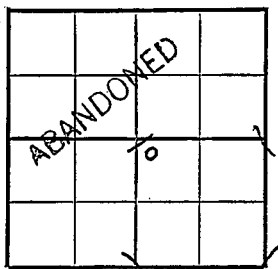El. 1868
SECTION PLAT330 Ft. from N. Line Ft. from S. Line Ft. from E. Line330 Ft. from W. LineBarton County

Location _____

Rig up _____

Drilling and Remarks:

8" @ 240

Anhy 730

Heeb. 3068

Br. line 3179

Lans. 3192

Cong. 3434

Arb. 3446

RECORD

Cased _____ in., _____ ft.

Sand _____

Gas _____

Oil _____

Total Depth 3496

PRODUCTION

1st 24 hrs. Nat. _____

1st 24 hrs. after shot _____

Gas _____ Cu. Ft.

Dry Hole _____

Abandoned _____

Date

JUN 21 1950

19

J. E. TYRA Scout

DST 3446-55

Open 30 min.

Rec. 81 mud

TD 3496

D & A

JUN 29 1930

Scout Cards
Land Small Map
Land Wall Map
Tracings
France Map
Pierce Map
Misc.

STATIONARY








 






