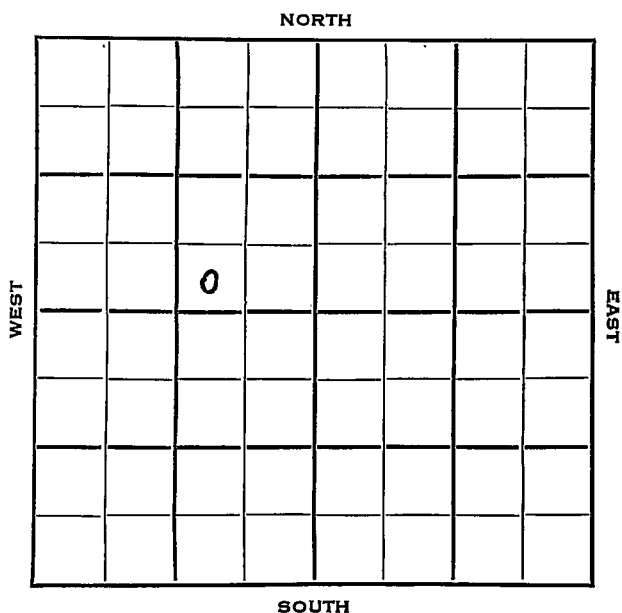


Section 26 Township 19 Range 14 WWell No. # 3 OpieCompany Honaker Drlg.

Barton

KANSAS 14W

Sec. 26 Twp. 19 R. 14W

Well No. #3 Opie Farm

Honaker Drlg. Company

Honaker Drlg. Contractor

Gt. Bend Airport Pool


Ft. from N. Line

330 Ft. from S. Line

990 Ft. from E. Line

Ft. from W. Line

SW SE NW

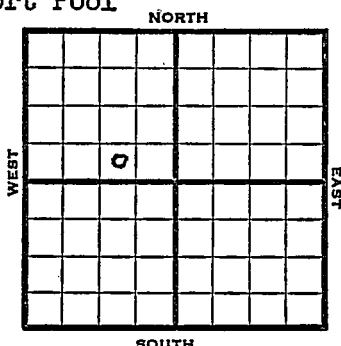

1953 Elev. 1874' REPORT

- 6/10 Spud 6-4-53
8" @ 798
Anhy 795
Drlg. 2050'
- 6/24 Heeb 3089, Br. L. 3184, Lans 3194
DST 3186-3205, $\frac{1}{2}$ hr, 160' gas, 20'
SOCM,
DST 3252-66, 1 hr, 225' SW
DST 3314-60
TD 3497'
5" @ 3497'
- 7/1 CO 3461 $\frac{1}{2}$ elec log 9/ 3382-85 FU 80'
oil 3 boph 500 A 436 boph, Arb
3496'.
- 7/8 NR
- 7/22 Spud 6-4-53
Oil Well
TD 3497
8" @ 798
Anhy 795, Heeb 3089, Br line 3184,
Lans 3194
DST 3186-3205, opn $\frac{1}{2}$ hrs., rec. 150'
gas, 20' socm,
DST 3252-66, opn 1 hr., rec. 225' sw,
DST 3314-60, TD 3497,

OVER

1953

7/22

5" @ 3497

CO to 3461

9/3382-85

FU 80' oil 3 boph 500A

F/36 boph

Arb. 3496

Comp. 323 bopd

COMPLETED

County Barton State KansasSec. 26 (Blk. Twp.) 19 (Sur. Rge.) 14W Map No.Operator Honaker Drig.Well No. 3 Farm OpieElev. Location SW SE NW

FIRST REPORT							

330 Ft. From S Line NW990 Ft. From E Line Quarter1st. Report JUN 10 1953

Completion

Remarks

Honaker Drig. - Contr.Spudding Date 6-4-53Drig. Data Gt. Bend Airport Pool8" @ 798 Anhy 795 drlg. 2050

J. G. McGEHEE

J. G. McGEHEE