

Section 22 Township 30s Range 8WWell No. #1 Rall^{dy}Company Magnolia

NORTH

							0

WEST

EAST

SOUTH

Kingman KANSAS

Sec. 22 Twp. 30 R. 8 W ☒

Well No. # 1 Rall Farm

Magnolia Pet. Company

Spivey Pool Contractor


990 Ft. from N. Line

 Ft. from S. Line

330 Ft. from E. Line

 Ft. from W. Line

SE NE NE

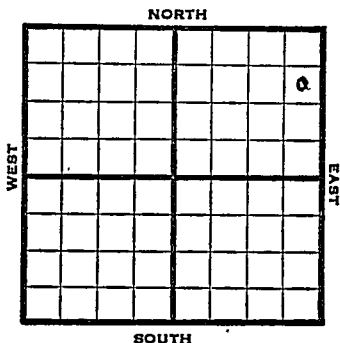

1952

Elev. 1539' REPORT

1/2

Location

2/6

Viola 4553

DST 4554-63 , 1 hr. 56' OCM

555# BHP TD 4563

6-5/8" @4555 DP

2/13

CO to TD A 1000 S/ 2 BSW ph &
scum oil Fishing bailer

2/20

Fish out Set pkg 4234

48/4198-4214 test wtr 2000#

B/2 gal oil & 15 gal wtr 1 hr.

Hyd. SI load

3/5

2000 A S&B 1/2 Bot 3 1/2 BSW ph for
6 hrs. Sq perfs DO 3834

24/3792-3800 NS 24/3804-10 NS

12/3812-16 NS 36/3819-29 NS

3000 A S/3 BSWPH & SG&O

To sq off

3/12

Sq perfs CO at 3900'

3/19

Spud 1-4-52

Gas well TD 4563' 13" @ 195

Lans. 3420'

DST 3795-3817 open 1 hr. rec 62' SOCM

DST 3848-54 open 1 hr. rec 90' O &
GCM.

DST 3877-94 open 1 hr. 600,000 gas
275' HO & GCM, 100' water.

OVER

1952

3/19

Spud 1-4-52

Gas well TD 4563'

13" @ 195' Lans. 3420'

DST 3795-3817 open 1 hr, rec 62'

SOCM

DST 3848-54 open 1 hr. rec 90' O & GCM

DST 3877-94 open 1 hr, 600,000 gas, 275' HO & GCM, 100' water

Miss 4201' Viola 4553'

DST 4554-63 open 1 hr, rec 56' OCM

TD 4563' 6-5/8" @ 4555 CO to TD

1000 A S/2 BSWPH scum oil DP 4234'

48/4198-4214 water 2000 A

B/2 GO 15 GW 1 hr. Hydro

S/load S/25 BSWPH 10 hr.

SP 3900 16/3776-80 water

16/3880-84 B/5 GWPH 2000 A

F/6 $\frac{1}{4}$ M gas SP 3865' 24/3845-52

dry 24/3852-58 water 2000 A

S & B/1 $\frac{1}{2}$ BO 3 $\frac{1}{2}$ BSWPH 6 hr. DP 3834'

24/3792-3800 24/3804-10 12/3812-16

36/3819-29 3000 A S/3 BSWPH

CO to 3900

Comp. shut in gas well

F/3,500,000 gas

COMPLETED

455.3
1537
3014

County Kingman State KansasSec. 22 (Blk. Twp.) 30 (Sur. Rge.) 8W Map No.Operator Magnolia Pet.Well No. 1 Farm RailElev. Location SE NE NE

990 Ft. From N Line NE330 Ft. From E Line Quarter1st. Report JAN 2 1952

Completion


Remarks

Spudding Date

Drilg. Data Spivey PoolLocation

J. E. TYRA

County Kingman State Kansas
 Sec. 22 (Blk. 30) (Sur. 8W) (Twp.) (Rge.) Map No.
 Operator Magnolia Pet.
 Well No. 1 Farm Rall
 Elev. 1539 Location SE NE NE

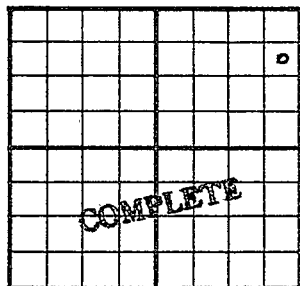990 Ft. From N Line NE330 Ft. From E Line Quarter

1st. Report

Completion MAR 19 1952Remarks Spivey PoolSpudding Date 1-4-52Drlg. Data Gas well TD 456313" @ 195 Lans. 3420 DST 3795-3817open 1 hr. Rec. 62' s ocm DST 3848-54open 1 hr. Rec. 90' o & gcm DST 3877-94 open 1 hr. 600,000 gas 275' ho &gcm 100' water Miss. 4201 Viola 4553DST 4554-63 open 1 hr. Rec. 56' ocmTD 4563 6 5/8" @ 4555 CO to TD1000 A S/ 2 bswph scum oil DP 423448/ 4198-4214 water 2000 A B/ 2 go15 gw 1 hr. Hydro. S/ load S/ 25bswph 10 hr. SP 3900 16/ 3776-80water 16/ 3880-84 B/ 5 gwph 2000 AF/ 6 1/2 M gas SP 3865 24/ 3845-52

J. G. McGEHEE

Drlg. Data

dry 24/ 3852-58 water 2000 A

S & B/ $\frac{1}{2}$ bo $3\frac{1}{2}$ bswph 6 hr. DP 3834

24/ 3792-3800 24/ 3804-10 12/ 3812-16

36/ 3819-29 3000 A S/ 3 bswph

CO to 3900 Comp. shut in gas well

F/ 3,500,000 gas

Scout Cards
Land Small Map
Land Wall Map
Tracing
France Map
Pierce Map
Misc.

MAR 25 1952