

KANSAS

Section 35 Township 15 Range 14WWell No. 3 Schmeidler "B"Company Aladdin Pet.

Trapp Pool

NORTH

|  |  |   |  |  |  |  |  |
|--|--|---|--|--|--|--|--|
|  |  |   |  |  |  |  |  |
|  |  | 0 |  |  |  |  |  |
|  |  |   |  |  |  |  |  |
|  |  |   |  |  |  |  |  |
WEST

EAST

SOUTH

**HOT FILE**

KANSAS

Russell

14W

Sec. 35 Twp. 15 R. 14W

Well No. #3 Schmeidler "B" Farm

Aladdin Pet.

Company

Trapp Pool


990' Ft. from N. Line

Ft. from S. Line

990' Ft. from E. Line

Ft. from W. Line

SW NE SW

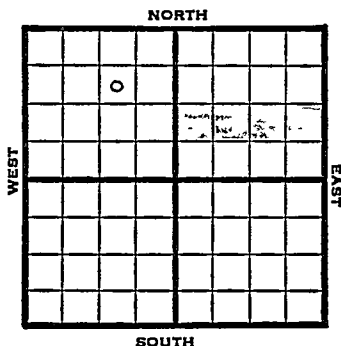

1948

Eli 1917'

REPORT

10/20

8" @ 252'

Anhy. 905'

Drlg. 2025'

10/26

Lansing 3117'

Arb. 3353-56'

TD 3356'

5" @ 3354'

11/3

Swb 10 bbls oil PH - 3 hrs.

11/10

"

11/16

"

11/23

"

12/1

TD 3356'

Arb. 3353'

5" @ 3354'

Pump 67 Oil / 7% W Pot

409 Gr.

Comp

**COMPLETED**

Map No. \_\_\_\_\_ Sec. 35 Twp. 15 R. 14W

Well No. 3 Schmeidler "B"

Aladdin Pet. Company

FIRST REPORT Contractor

SW NE NW


SECTION PLAT

990 Ft. from N. Line

\_\_\_\_\_ Ft. from S. Line

990 Ft. from E. Line

\_\_\_\_\_ Ft. from W. Line

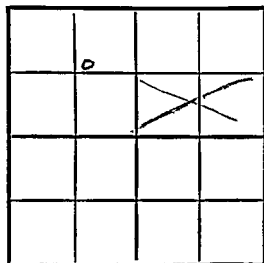

Russell County

Location \_\_\_\_\_

Rig up \_\_\_\_\_

Drilling and Remarks:

8" @ 252

Anhy 905

drlg. 2025

RECORD

Cased \_\_\_\_\_ in., \_\_\_\_\_ ft.

Sand \_\_\_\_\_

Gas \_\_\_\_\_

Oil \_\_\_\_\_

Total Depth \_\_\_\_\_

PRODUCTION

1st 24 hrs. Nat. \_\_\_\_\_

1st 24 hrs. after shot \_\_\_\_\_

Gas \_\_\_\_\_ Cu. Ft.

Dry Hole \_\_\_\_\_

Abandoned \_\_\_\_\_

Date

OCT 20 1948

19

S. J. LEWIS

Scout

Map No. 73 Sec. 35 Twp. 15 R. 14W

Well No. 3 Schmeidler "B"

Aladdin Pet.

Company

**COMPLETE**

Contractor

SW NE NW

*E. 1917*  
**SECTION PLAT**

990 Ft. from N. Line

       Ft. from S. Line

990 Ft. from E. Line

       Ft. from W. Line

|  |   |  |  |
|--|---|--|--|
|  |   |  |  |
|  | 6 |  |  |
|  |   |  |  |
|  |   |  |  |
|  |   |  |  |

Russell County

Location                     

Rig up                     

Drilling and Remarks:

*Cert 3353*

*5" 28354*

*Pump 67 oil + 7 gas*  
*PT*

*402 cu*

**RECORD**

Cased            in.,            ft.

Sand                     

Gas                     

Oil                     

Total Depth 3356

**PRODUCTION**

1st 24 hrs. Nat.                     

1st 24 hrs. after shot                     

Gas                      Cu. Ft.

Dry Hole                     

Abandoned                     

Date

DEC 1 1948 19

**S. J. LEWIS**

Scout