

DX 78-1

O.W.W.O.

Morton

KANSAS


O.W.W.O.

Section 31 Township 31 Range 12 WWell No. #1 Land BankCompany Panhandle ~~Electric~~

NORTH

WEST

EAST

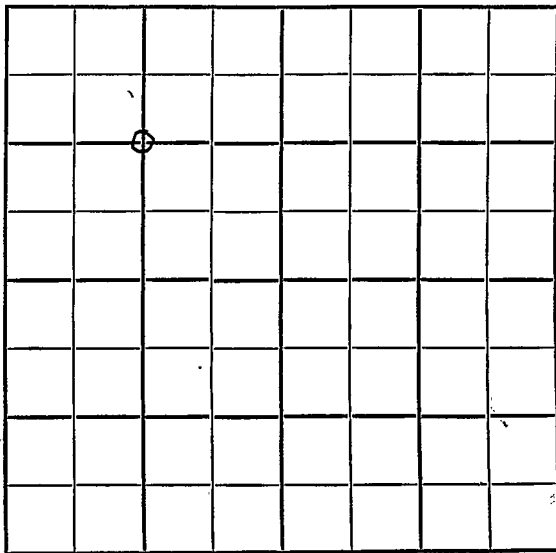

SOUTH

O.W.W.O.

Morton

KANSAS

SEC.	TWP.	R.
34	34	42W

WELL NO.

#1 Land Bank

FARM

COMPANY

Panhandle Eastern

CONTRACTOR

Garvey

Greenwood


_____ Ft. from N. Line

_____ Ft. from S. Line

_____ Ft. from E. Line

_____ Ft. from W. Line

C NW/4

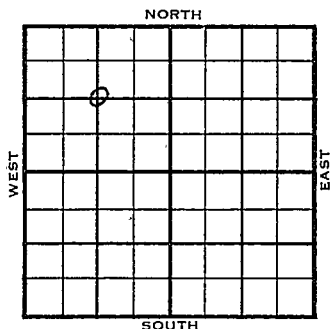

1955

ELEVATION

3535'

REPORT

10/5

Comm 10-1-55
Drlg 1055

11-16

8" @ 1518/775

DST 2853-2900 op 75 min. gas in 6 min.
1,360 mcfg in 40 min., rec 200' gcm
540/20"DST 3075-3118 op 80 min. 60 mcfg, rec.
140' gcm, 435#

DST 3296-3309 op 45 min. rec. 5' mud.

DST 3336-3400 op 35 min. gas in 2 1/2 min.

1,772 mcfg in 5 min. rec 245' gcm
630/20"DST 3738-71 op 1 1/2 hr. gas in 60 min.
rec. 20' gcm 780/20"

DST 3900-85 op 1/2 hr. gas in 2 min.

4 mcfg in 20 min. rec. 75' gcm 920/20"

DST 4343-68 op 1 hr. gas in 5 min.,

458 mcfg in 10 min. 284 mcfg in 50 min.
rec 65' mud. 1210/20"

DST 4475-4508 op 45 min. gas in 2 min.

2,800 mcfg in 5 min. 4,256 mcfg in 40
min. rec 180' sw 975/20"

5 1/2" @ 4597-600

CO to 4555, 3/ 4512-13, 2,400 mcfg

63/ 4502-12, 20 min. BD 6,860 mcfg.

60/ 4492-4502 20 min. BD 9700 mcfg.

11-16

60/ 4482-92, 2 $\frac{1}{2}$ hr. 14 mcf. 500 A
frac 12,375 mcf 5000 A, 17, 922 mcf
20 min. BD 2000 A, 22,150 mcf. 20 min.
BD

Comp. open flow 15,800 mcf/gpd

<u>TOPS</u>	<u>LOG</u>
Waub	2632
Tp.	2831
L.	3258
Marm	3791
Ce.	3877
#####	#####
Atoka	4019
Morrow sh	4104
Keyes	4469
M.	4540
TD.	4600'

--

COMPLETED

1956
3/14

O.W.W.O.

OTD 4600 5" @ 4597 SP 3930
9/3918-20 3 MCFG SP 3900
CO to 3925 9/3880-81 FU 350' mud
& wtr. 30 mins. SP 3879' Sq/w/300
WOC

Tops: Waub. 2632', Top. 2831',
KC 3258', Marm. 3791', Cherokee 3877'
Atoka 4019', Morrow 4104', Keyes 4469'
Miss. 4540'

7-18 CO to 3925, 32/3894-3902, 8250 mcf, 1000 A, 15,620 mcf, 3000 A, 17,928 mcf,
CO to 4600, 27,200 mcf,
PB 4465, 15,800 mcf, 32/3442-50
12,900 mcf, 1000 A, SP 4433
Comp. open flow 19,700 mcf/gpd
TD 4600'

COMPLETED

County Morton

Elev. _____

Sec. 31 Twp. 31 Rge. 12WCompany Ponbodie EasternFarm Name Land BankNo. 1

TOPS

DEPTH

LOG

DATUM

Loc. in Sec. _____

Anh. _____

Tp. _____

H. _____

Tr. _____

Dg. _____

Bl. _____

L. _____

K.C. _____

B.K.C. _____

Ce. _____

C. _____

M. _____

M. _____

K. _____

Mz. _____

Me. _____

V. _____

S. _____

S. _____

A. _____

R. _____

PE. _____

G. _____

T.D. _____

C NW 1/4Morrow test

Geol. _____

Contr. _____

Garvey

Pool _____

Greenwood

FIRST REPORT

OCT 5 '55

Date Comm. 10-1-55drlg. 195554

County Morton Elev. 3535
 Sec. 34 Twp. 34 Rge. 42W
 Company Panhandle Eastern
 Farm Name Land Bank No. 1

TOPS	DEPTH	LOG	DATUM	Loc. in Sec.
Anb. <u>Wauls</u>		<u>2632</u>		<u>C NW/4</u>
TP.		<u>2831</u>		
H.				
Tr.				
Dg.				
BL.				
L.		<u>3258</u>		
K.C. <u>Manna</u>		<u>3791</u>		Geol.
B.K.C.				Contr.
Ce.		<u>3877</u>		<u>Garvey</u>
C. <u>Atkins</u>		<u>4019</u>		
M. <u>Maaniasaki</u>		<u>4104</u>		
M. <u>Reeses</u>		<u>4469</u>		Pool
K. <u>m.1</u>		<u>4540</u>		<u>Greenwood</u>
Mz.				
Mq.				
V.				
S.				
S.				
A.				
R.				
PE.				
G.				
T.D.	<u>4600</u>			

COMPLETE

Date Comm. 10-1-55 NOV 1 6 1955

8" @ 1518/775 DST 2853-2900

open 75 min. gas in 6 min. 1.360 mcf/g

in 40 min. . rec. 200' gcm. 540/20"

DST 3075-3118 open 80 min. 60 mcf/g

rec. 140' gcm 435# DST 3296-3309

open 45 min. rec. 5' mud DST 3336-3400

open 35 min. gas in 2 1/2 min.

1,772 mcf/g in 5 min. rec. 245' gcm 630/20"

DST 3738-71 open 1 1/2 hr.

gas in 60 min. rec. 20' gcm 780/20"
 DST 3900-85 open $\frac{1}{2}$ hr. gas in 2 min.
 4 mcfg in 20 min. rec. 75' gcm 920/20"
 DST 4343-68 open 1 hr. gas in 5 min.
 458 mcfg in 10 min. 284 mcfg in 50 min.
 rec. 65' mud 1210/20" DST 4475-4508
 open 45 min. gas in 2 min. 2,800 mcfg
 in 5 min. 4,256 mcfg in 40 min. Rec.
 180' sw 975/20" 5 $\frac{1}{2}$ " @ 4597-600
 CO to 4555 3/ 4512-13 2,400 mdfg
 63/ 4502-12 20 min. BD 6,860 mcfg
 60/ 4492-4502 20 min. BD 9,700 mcfg
 60/ 4482-92 2 $\frac{1}{2}$ hr. 14 mcfg 500 A
 frac 12,375 mcfg 5000 A 17,922 mcfg
 20 min. BD 2000 A 22,150 mcfg
 20 min. BD Comp. open flow 15,800 mcfgpd

Scout Cards <i>M</i>
Land Small Map
Land Wall Map
Tracings
Frame Map
Place Map
Misc.

NOV 25 1955


O.W.W.O.

OWWO

FORM 513 REV. SUNRAY

County Morton Elev. 3535
 Sec. 34 Twp. 34 Rge. 42W
 Company Panhandle Eastern
 FarmName Land Bank No. 1

TOPS	DEPTH	LOG	DATUM	Loc. in Sec.
Anh.				C NW/4
TP.				
H. <u>Waub.</u>	<u>2632</u>			
Tr. <u>Top.</u>	<u>2031</u>			
Dg.				
BL.				
L.				Geol.
K.C.	<u>3258</u>			
B.K.C. <u>Marm.</u>	<u>3791</u>			Contr.
Ce. <u>Cherokee</u>	<u>3877</u>			
C. <u>Atoka</u>	<u>4019</u>			
Morrow	<u>4101</u>			
M. <u>Keyes</u>	<u>4169</u>			Pool
K. <u>Miss</u>	<u>4540</u>			<u>Greenwood</u>
Mz.				
Mo.				
V.				
S.				
S.				
A.				
R.				
PC.				
G.				
T.D.				

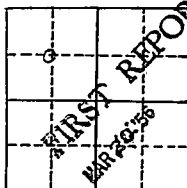

MAR 14 1956

Date Comm.

OTD 4600 5" @ 4597 SP 3930

9/ 3918-20 3 mcfg SP 3900 GO to 3925

9/ 3880-81 FU 350' mud & wtr. 30 min.

SP 3879 sq. w/ 300 WOG

County Morton Elev. 3535
 Sec. 34 Twp. 34 Rge. 42W
 Company Panhandle Eastern
 Farm Name Land Bank No. 1

TOPS	DEPTH	LOG	DATUM	Loc. in Sec.
Anh.				C NW/4
Tp.				OWWO
H. <u>Waub.</u>	<u>2632</u>			
Tr. <u>Top</u>	<u>2831</u>			
Dg.				
Bl.				
L.				
K.C.	<u>3258</u>			Geol.
B.K.C. <u>Marm</u>	<u>3791</u>			Contr.
Ce. <u>Cherokee</u>	<u>3877</u>			
C. <u>Atoka</u>	<u>4019</u>			
M. <u>Mw</u>	<u>4104</u>			
M. <u>Keyes</u>	<u>4469</u>			Pool
K. <u>Mw</u>	<u>4540</u>			Greenwood
Mz.				
Mo.				
V.				
S.				
S.				
A.				
R.				
P.E.				
G.				
T.D.	<u>4600</u>			

COMPLETE

JUL 10 1956

Date Comm.

OTD 4600 5" @ 4597 SP 3930
 9/ 3918-20 3 mcf/g SP 3900 CO to 3925
 9/ 3880-81 FU 350' mud & wtr. 30 min.
 SP 3879 CO to 3925 32/ 3894-3902
 8,250 mcf/g 1000 A 15,620 mcf/g
 3000 A 17,928 mcf/g CO to 4600
 27,200 mcf/g PB 4465 15,800 mcf/g
 32/ 3442-50 12,900 mcf/g 1000 A

SP 4433

Comp. open flow 19,700 mcf/gpd

R. G.

JUL 3 0 1956

SEP 25 57
FIRST REPORT

LOC. C NW/4

[illegible]

GEOL. _____

CONTR. _____

POOL Taloga

SPUD _____

OTD 4600 CO 4514

24/ 1500-12 20/ 4484

94 1,500 mcf g WOT

RGF

Twp. ~~X~~ Pool ~~X~~ K-20
 Co. ~~X~~ Facet ~~X~~
 O.W.W.O.

CORRECTION

S-513-A

CO. Morton ELEV. 3535
 SEC. 34 TWP. 34 RGE. 12W
 COMPANY Panhandle NO. 1-34

APR 9 '58

COMPLETE

FARM Land Bank

LOC. C NW 1/4 **(UENVO)** **O.W.W.O.**

Cher.	3877
Morrow	4104

GEOL. _____
 CONTR. _____
 POOL Taloga
 SPUD. _____
OTD 4600 GO 4514
24/ 4500-12 20/ 41.1
94 1,500 mcf/g NOT
DEC 2 '57 DEC 5 '57 DEC 10 '57
10 157 15 147 20 137
20 127 10 20" op fl.

TD 4600

1.862 mcf thru 76g.
ga 2.842 mcf WO Test

DEC 4 '57
 JAN 2 '58 WO JAN 8 '58
 JAN 15 '58 P WO Test
 JAN 22 '58 JAN 29 '58 FEB 12 '58 FEB 19 '58
 MAR 5 '58 MAR 12 '58 MAR 19 '58 MAR 26 '58
 APR 2 '58 APR 9 '58 Proc with oil

State del 5.042 mcf
RP 440

keys 4484-4512

NO. SEC. TWP. RGE.