

Section 29 Township 13 Range 14W

Well No. #2 Miller (B)

Company D. R. Lauck Oil

NORTH

WEST

EAST

SOUTH

0

Russell

KANSAS ✓

Sec. 29 Twp. 13 R. 14W

Well No. #2 Miller (B) Farm

D. R. Lauck Oil Company

Contractor


990 Ft. from N. Line

Ft. from S. Line

990 Ft. from E. Line

Ft. from W. Line

SW NE SW

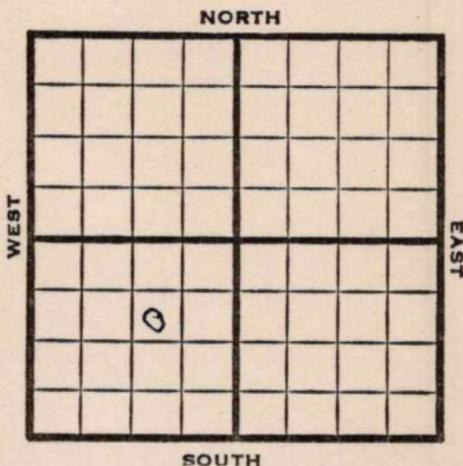

1952

Elev. 1864'

REPORT

8/13 Spud 8-9-52
8" @ 196'
Anhy 920
Drlg. 1765'

8/20 Heeb 2977' Lans. 3028'
DST 3045-79, 1 hr, 900' gas, 430' V
HOCM, 720# Arb. 3301' RTD 3304'
5" @ 3303'

8/27 Spud 8-9-52
Oil Well TD 3314' 8" @ 196'
Anhy 920 Heeb. 2977
Lans. 3028
DST 3045-79 open 1 hr. rec. 900'
gas 430' vhocm 720#
Arb. 3301 TD 3304 5" @ 3303
DD 3310 250 A S/ 2 boph DD 3314
Comp. 50 bopd

COMPLETED

