


Section 18 Township 34 Range 42W

Well No. 1 Scott

Company Colorado O&G

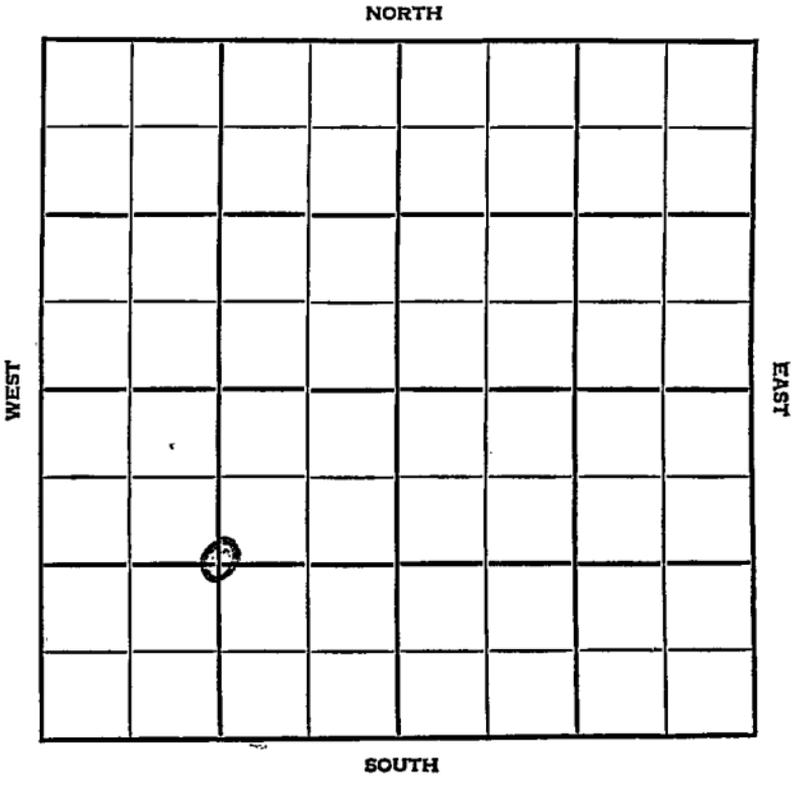

## Morton

KANSAS

SEC.	18	TWP.	34	R.	42W
------	----	------	----	----	-----

WELL NO. 1 Scoté FARM

COMPANY Colorado O & G

CONTRACTOR Garvey  
Greenwood


\_\_\_\_\_ Ft. from N. Line

\_\_\_\_\_ Ft. from S. Line

\_\_\_\_\_ Ft. from E. Line

\_\_\_\_\_ Ft. from W. Line

C SW/4

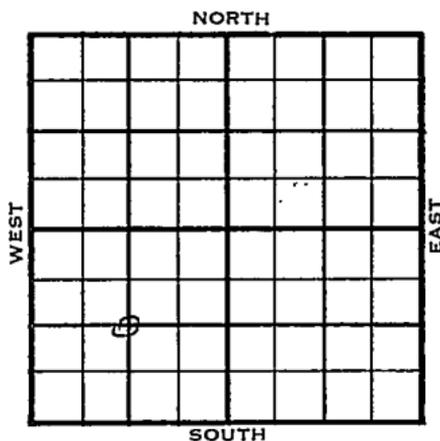

	ELEVATION	REPORT
1955	3466	
6/29	Comm 6-31-55 8" @ 498/400 Dr1g 2890	
8/10	5 1/2" @ 3090/150 CO to 3060 12/3021-24 52/3004-17, 3500A 2,160 mcfg SP 2990 perf/ 2821-22 SP 2794 CO to 2990 24/ 2944-50 60/2907-22 24/2872-78 32/2882- 95 8000 A 2,852 mcfg 65 gwph SP 2865 12/2848-51 16/ 2824-28 16/2798-2802, 16/2774-78 45 gwph 3000A 200 gwph CO to 2864 8/2734-36 24/2710-16 200 gwph CO to 2703 12/2592-95 24/2569-75 2000A 582,000 cfig 30 gwph SP 3059 5,261 mcfg Comp. 7,959 mcfgpd 422# Anh. Waub 2552, Tp. Element: 2759, H. Top: 2870, Tr. Le Comp: 2927, TD: 3099.	
		COMPLETED

County Morton Elev. \_\_\_\_\_  
 Sec. 18 Twp. 34 Rge. 42W  
 Company Colorado O & G  
 FarmName Scott No. 1

TOPS	DEPTH	LOG	DATUM
Anh.			
TP.			
H.			
Tr.			
Dg.			
Bl.			
L.			
K.C.			
B.K.C.			
Ce.			
C.			
M.			
M.			
K.			
Mz.			
Me.			
V.			
S.			
S.			
A.			
R.			
PC.			
G.			
TD.			

Loc. in Sec. C SW/4  
 Geol. \_\_\_\_\_  
 Contr. Garvey  
 Pool Greenwood  
 FIRST REPORT  
 JUN 29 55

Date Comm. 6-21-55  
8" @ 498/400 drlg. 2890

*[Handwritten signature]*

Co.  
Lse.  
No.  
Sec.  
T.  
R.

County Morton Elev. 3466Sec. 18 Twp. 34 Rgs. 1,2WCompany Colorado O & GFarm Name Scott No. 1

TOPS	DEPTH	LOG	DATUM
Anh. <u>Waub</u>		<u>2552</u>	
Tp. <u>Elment</u>		<u>2759</u>	
H. <u>Tap</u>		<u>2870</u>	
Tr. <u>LoComp</u>		<u>2927</u>	
Dg.			
Bl.			
L.			
K.C.			
B.K.C.			
Ce.			
C.			
M.			
M.			
K.			
Mz.			
Me.			
V.			
S.			
S.			
A.			
R.			
PE.			
G.			
T.D.	<u>3099</u>		

Loc. in Sec. \_\_\_\_\_

C SW/4

Geol. \_\_\_\_\_

Contr. \_\_\_\_\_

Garvey

Pool \_\_\_\_\_

Greenwood

COMPLETE

AUG 1 6 1955

Date Comm. 6-21-558" @ 1498/1400 5 1/2" @ 3090/150CO to 3060 12/ 3021-24 52/ 3004-173500 A 2,160 mcfg SP 2990perf/ 2821-22 SP 2794 CO to 299024/ 2944-50 60/ 2907-22 24/ 2872-7832/ 2882-95 8000 A 2,852 mcfg65 gwph SP 2865 12/ 2848-51 ..16/ 2824-28 16/ 2798-2802

OVER

16/ 277 $\frac{1}{4}$ -78 1 $\frac{1}{2}$  gwph 3000 A 200 gwph  
CO to 286 $\frac{1}{4}$  8/ 273 $\frac{1}{4}$ -36 2 $\frac{1}{4}$ / 2710-16  
200 gwph CO to 2703 12/ 2592-95  
2 $\frac{1}{4}$ / 2569-75 2000 A 582,000 cfg  
30 gwph SP 3059 5,261 mcfg  
Comp. 7,959 mcfgpd 1422#

.....	Misc.
.....	Phone Map
.....	Trail Map
.....	Tracers
.....	Land Wall
.....	Land Small Map
.....	Scout Cards

*[Handwritten signature]*

AUG 17 1955