

KANSAS

Russell

FORM 51 25M 3-49 PETROL

Section 35 Township 14 Range 15-W

Well No. #1 Hall

Company Lario Oil & Gas
Big Creek Pool

NORTH

WEST

EAST

SOUTH

							0

1

[Handwritten signature]

Russell **Antonia**

Sec. 35 Twp. 14 R. 15W

Well No. #1 Hall Farm _____

Lario Oil & Gas Company

Big Creek Pool (Sterling Drlg., Co. Contr.)


330' Ft. from N. Line

_____ Ft. from S. Line

330' Ft. from E. Line

_____ Ft. from W. Line

NE/C

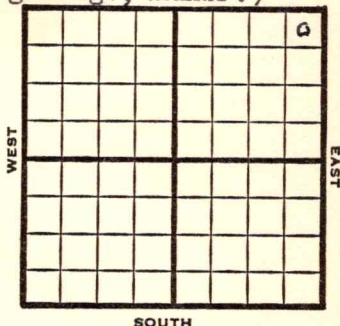

1949

Elev. 1796'

R E P O R T

11/30

Surface Hole

1950

1/25

8" @ 882'

5" @ 3242'

Perf 5/322-27

P-40 BO & 182 BWPD

TD 3242'

COMPLETED

Map No. _____ Sec. 35 Twp. 14 R. 15W

Well No. 1 Hall

Lario Oil & Gas Company

Sterling Drlg. Contractor

NE/C

FIRST REPORT
SECTION PLAT

330 Ft. from N. Line

_____ Ft. from S. Line

330 Ft. from E. Line

_____ Ft. from W. Line

			o

Russell County

Location _____

Rig up _____

Drilling and Remarks:

surface hole

RECORD

Cased _____ in., _____ ft.

Sand _____

Gas _____

Oil _____

Total Depth _____

PRODUCTION

1st 24 hrs. Nat. _____

1st 24 hrs. after shot _____

Gas _____ Cu. Ft.

Dry Hole _____

Abandoned _____

Date

NOV 30 1949 19

S. J. LEWIS Scout

Kansas

Map No. _____ Sec. 35 Twp. 14 R. 15W

Well No. 1 Hall

Lario Oil & Gas Company

Contractor

NE/C


E. 1796
SECTION PLAT

330 Ft. from N. Line

_____ Ft. from S. Line

330 Ft. from E. Line

_____ Ft. from W. Line

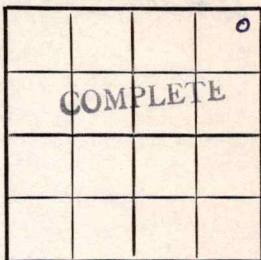

Russell County

Location _____

Rig up _____

Drilling and Remarks:

8" @ 882
5" @ 3242'
Per F 5/322-27
P-40 B0 + 182
BWPD
C

RECORD

Cased _____ in., _____ ft.

Sand _____

Gas _____

Oil _____

Total Depth 3242

PRODUCTION

1st 24 hrs. Nat. _____

1st 24 hrs. after shot _____

Gas _____ Cu. Ft.

Dry Hole _____


Abandoned _____

Date

JAN 25 1950

J. E. TYRA

Ark 800
 Topeka 2702
 Kans 2982
 Cong 3219
 Ark 3225

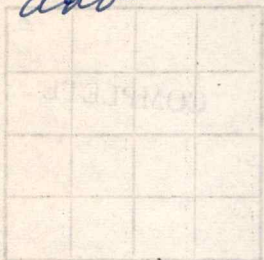

Ft. from N. Line
 Ft. from S. Line
 Ft. from E. Line
 Ft. from W. Line

RECORD

Scout Cards
 Land Small Map
 Land Wall Map
 Tracings
 France Map
 Pierce Map
 Misc

[Handwritten signature]

JAN 30 1950

Date

U. S. T. Y. R. A.

Scout

18