

Russell

W.D.D. KANSAS

✓✓

Sec. 29

Twp.

13

R.

14W

Well No. #3 Miller (B)

Farm

D. R. Lauck

Company

Contractor

Ft. from N. Line

990'


Ft. from S. Line

990'

Ft. from E. Line

Ft. from W. Line

NW SE SW

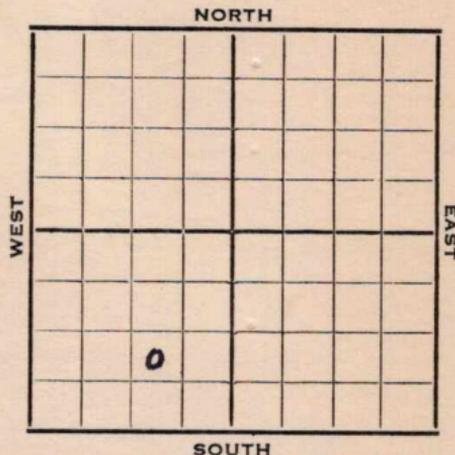

1952

Elev. 1876'

REPORT

8/27

Spud 8-23-52
8" @ 199
Drlg. 1284'

9/3

Heeb. 2991 **Lans. 3048**
DST 2945-3068, 1 hr. 180' wtr.
1400#
DST 3053-77, 1 hr. 37' WCM 600#
DST 3082-96, 1 hr. 60'm 450#
Drlg. 3251'

9/10

Arb. 3320' RTD 3336' 5" @ 3322'

9/17

DD 3336½

9/24

Spud 8-23-52
Oil Well TD 3336½ 8" @ 199'
Heeb. 2991 **Lans. 3048**
DST 2945-3063 open 1 hr. rec. 180' wtr.
1400#
DST 3053-77 open 1 hr. rec. 37' wcm
600#
DST 3082-96 open 1 hr. rec. 60' mud
450# **Arb. 3320** TD 3336
5" @ 3322 DD 3336½ P/ 2 boph
Comp. 40 bopd

COMPLETED

OVER

732734

#3 Miller "B"

O. W. D. D

1953

4/15

OWDD for SWD

Arb. 3320

OTD 3336

5" @ 3322

DD 3395

4/23

NR

4/29

Abd.

TD 3395

Arb. 3320

OTD 3336

5" @ 3322

DD 3395

Abd.

ABANDONED

