


Map No. Kansas Sec. 14 Twp. 21 R. 13

Well No. 1 - O. Moore Farm

Ritchie Moore Company

NORTH

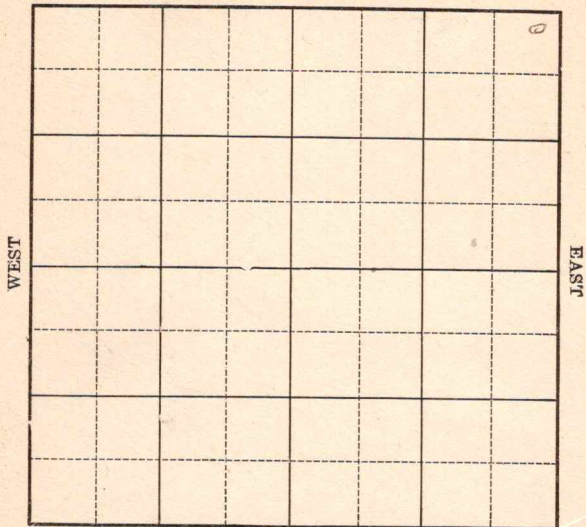

SOUTH

Location _____

Rig Up _____

Drilling Remarks _____

Drilling Remarks _____

RECORD

PRODUCTION

Cased _____ in. _____ ft.

1st 24 hrs. Nat. _____

Sand _____

1st 24 hrs. after shot _____

Gas _____

Gas _____ cu. ft.

Oil _____

Dry Hole _____


Total Depth _____

Abandoned _____

Map No. Kansas Sec. 14 Twp. 21 R. 13
 Well No. 1 O'mara Farm
Ritchie & Moore Company

Coffey

250 Ft. from N. Line
 _____ Ft. from S. Line
250 Ft. from E. Line
 _____ Ft. from W. Line

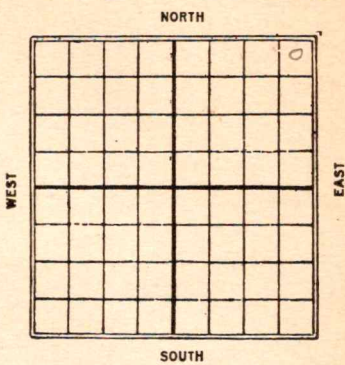

Date	REPORT
1/26	
3/18	Location
3/25	_____
4/1	_____
4/7	_____
4/15	_____
4/21	_____
4/30	_____
5/8	Same.
5/12	Same.
5/12	Same.
6/2	Spudding.
6/10	Dry 740'
6/18	" 1125'
6/25	Show oil 1450-55'
6/25	fishing 15-20'
6/30	_____
7/1	_____
7/15	same
7/22	S.D. 1720'
7/28	top line 1815' fishing
8/4	_____
8/18	Show oil 1450-55'
8/18	top line 1815' (over)

D & F 1862 - 1st bk.

H. F. W. - T. D. 1862

0.9804

Map No. *KANSAS* Sec. *14* Twp. *21* R. *13*

Well No. *1 O'Mara*
Ritchie Q Moore Company

Contractor

FIRST REPORTS

SECTION PLAT

250 Ft. from N. Line
Ft. from S. Line
250 Ft. from E. Line
Ft. from W. Line

			o

Location -----
Rig up -----
Drilling and Remarks:

RECORD

Cased ----- in., ----- ft.
Sand -----
Gas -----
Oil -----
Total Depth -----

PRODUCTION

1st 24 hrs. Nat. -----
1st 24 hrs. after shot -----
Gas ----- Cu. Ft.
Dry Hole -----
Abandoned -----

Date

MAR 18 1926

CHAS. L. SHERWOOD

192

Scout

Coffey

no map
KANSAS

Map No. _____ Sec. *14* Twp. *21* R. *13*

Well No. _____
10 moly
Riche & Moore

Company _____

Contractor _____

COMPLETED

SECTION PLAT

250 Ft. from N. Line

_____ Ft. from S. Line

250 Ft. from E. Line

_____ Ft. from W. Line

ABANDONED

			o

Location _____

Rig up _____

Drilling and Remarks:

Show rd 1450-55'
Top line 1815'
DBG 1862' 15 BS
AFW

RECORD

Cased _____ in., _____ ft.

Sand _____

Gas _____

Oil _____

Total Depth *1862*

PRODUCTION

1st 24 hrs. Nat. _____

1st 24 hrs. after shot _____

Gas _____ Cu. Ft.

Dry Hole

Abandoned

Date

AUG 18 1926

CHAS. L. SHERWOOD

Scout

192