
Russell KANSAS

FORM 51 5M 10-41 PETROL

Section 10 Township 15 Range 15-W

Well No. #1 Donovan "C"

Company Wofl Creek

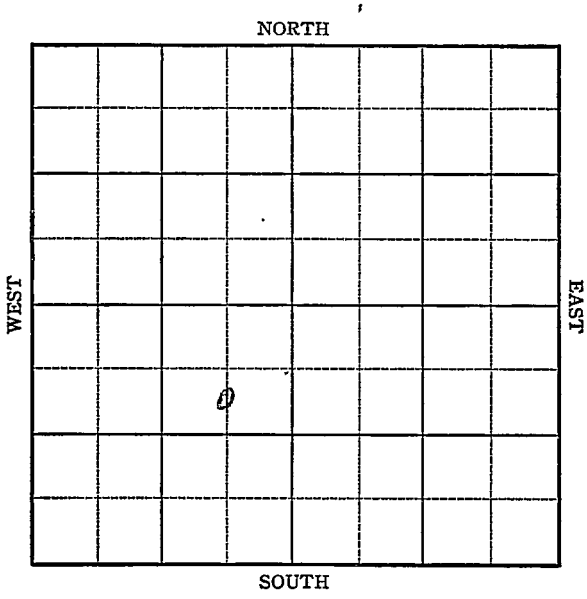

FORM 252-A
5M 10-41 PETROL

KANSAS Russell

Sec. 10 Twp. 15 R. 15-W

Well No. #1 Donovan "C" Farm

Wolf Creek Company


(Donovan)

990 Ft. from N. Line

_____ Ft. from S. Line

660 Ft. from E. Line

_____ Ft. from W. Line

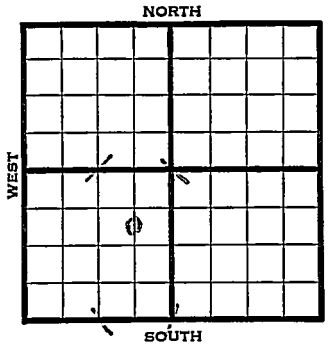

Elev. 1808

1941	REPORT
11/19	15" - 260'
	Fishing 300'
11/26	" "
12/4	12" - 555' Anhy 854'
	10" - 862' Drlg. 2360'
12/11	Shwo gas 2466-75
	8" @ 2472
	Drlg. 2745
12/18	Drlg. 2780 8" @ 2753
12/24	Lans. 3047' 7" - 3050' T.D. 3130' S.O
	U.R. 7".
12/31	Shut down.
1942	
1/8	" "
1/15	" "
1/22	Arb. 3254' ~~T.D. 3319' 100' wtr~~
	~~P.B.~~
1/29	7" - 3230' WOC.
	OVER

Form 26 200 Bks. 5-41 McW. Russell KANSAS

Map No. K-93 Sec. 10 Twp. 15 R. 15W

Well No. 1 Donovan "C"

Wolf Creek Company

FIRST REPORT Contractor

C SL NE SW

990 Ft. from N. Line


____ Ft. from S. Line

660 Ft. from E. Line

____ Ft. from W. Line

DONOVAN POOL

SECTION PLAT

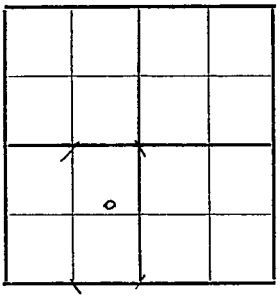

Location

Rig up

Drilling and Remarks:

15" - 260'

Fishing 300'

RECORD

Cased ____ in., ____ ft.

Sand

Gas

Oil

Total Depth

PRODUCTION

1st 24 hrs. Nat.

1st 24 hrs. after shot

Gas ____ Cu. Ft.

Dry Hole

Abandoned

Date

NOV 19 1941 19

S I LEWIS Scout

Form 26 200 Bks. 5-41 McW.

Russell KANSAS

Map No. 73 Sec. 10 Twp. 15 R. 15W

Well No. 1 Donovan "C"

Wolf Creek Company

COMPLETED Contractor

C SL NE SW


990 Ft. from N. Line

Ft. from S. Line

660 Ft. from E. Line

Ft. from W. Line

SECTION PLAT

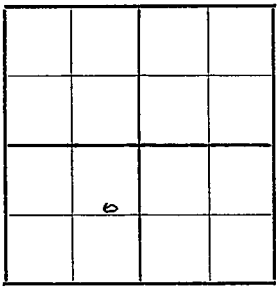

DONOVAN POOL

Location

Rig up

Drilling and Remarks:

L. anh 3049
7" @ 3230
Cir 3254
PBD 3227
9 Lahr to 3210-31
6000 acid
Pump 15 Bbl.
39 Bbl

RECORD

Cased in., ft.

Sand

Gas

Oil

Total Depth 3319

PRODUCTION

1st 24 hrs. Nat.

1st 24 hrs. after shot

Gas Cu. Ft.

Dry Hole

Abandoned

Date

JUL 8 1942 19

S. J. LEWIS Scout

1942

2/5 P.B. to 3227'
48 shots 3210-20' 3000 acid.
48 shots 3123-31' 3000 sacks.
Temp. potential Swab 15 bbls.

2/12 " " "

2/19 Waiting on pumping unit.

2/26 " " " "

3/5 " " " "

3/12 " " " "

3/19 " " " "

3/26 " " " "

4/2 " " " "

4/8 " " " "

4/15 Pump 25 oil & 60 water 12 hours.

4/22 " " " "

4/29 " " " "

5/6 " " " "

5/13 " " " "

5/20 " " " "

5/27 " " " "

6/3 " " " "

6/10 " " " "

6/17 " " " "

6/24 " " " "

7/1 " " " "

7/8 Lans. 3043'
7" - 3230'
Arb. 3254'
T.D. 3319'
P B. to 3227'
96 shots 3210-31'
6000 acid.
Potential 15 bbls., pump.
39. Gravity

COMPLETED